


STATE ENGINEER
Salem, Oregon

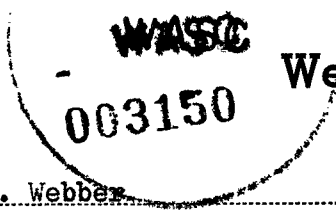

Well Record

STATE WELL NO. 2N/12-25R(2)
COUNTY Wasco
APPLICATION NO. U-219

OWNER: Ward R. Webber

MAILING ADDRESS: 412 Washington St.

LOCATION OF WELL: Owner's No. 3

CITY AND STATE: The Dalles, Oregon

SE 1/4 SE 1/4 Sec. 25 T. 2 N. 12 E. W, R. 12 W.M.

Bearing and distance from section or subdivision corner

Altitude at well

TYPE OF WELL: drilled Date Constructed 1946

Depth drilled 254 Depth cased 17'9"

Section 25

CASING RECORD:

6-inch set to 17'9"

FINISH:

open hole

AQUIFERS:

WATER LEVEL:

105' in 1946

PUMPING EQUIPMENT: Type Turbine H.P. 10
Capacity G.P.M.

WELL TESTS:

Drawdown ft. after hours G.P.M.

Drawdown ft. after hours G.P.M.

USE OF WATER Irrigation Temp. °F., 19.....

SOURCE OF INFORMATION U-219

DRILLER or DIGGER

ADDITIONAL DATA:

Log x Water Level Measurements Chemical Analysis Aquifer Test

REMARKS: Unable to measure depth to water 7/25/56

