

STATE ENGINEER
Salem, Oregon

WASCO
003253

Well Record

STATE WELL NO. 2N/13-29G(2)
COUNTY Wasco
APPLICATION NO. U-442

OWNER: Fred Wetle


MAILING ADDRESS:

LOCATION OF WELL: Owner's No.

CITY AND STATE:

SW 1/4 NE 1/4 Sec. 29 T. 2 N. E. R. 13 W. W.M.

Bearing and distance from section or subdivision corner

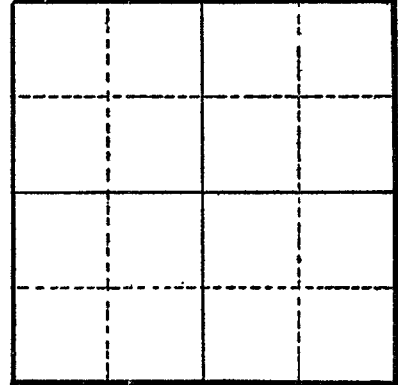

Section 29

Altitude at well

TYPE OF WELL: drilled Date Constructed 1950-51

Depth drilled 251 Depth cased 27

CASING RECORD:

8-inch, set to 27 feet

FINISH:

AQUIFERS:

WATER LEVEL: 85 ft. July 1951

PUMPING EQUIPMENT: Type Turbine H.P. 15
Capacity G.P.M.

WELL TESTS:
Drawdown 20 ft. after hours pumping 200 G.P.M.
Drawdown ft. after hours G.P.M.

USE OF WATER Temp. °F., 19

SOURCE OF INFORMATION

DRILLER or DIGGER

ADDITIONAL DATA:

Log Water Level Measurements Chemical Analysis Aquifer Test

REMARKS:

