

STATE ENGINEER
Salem, Oregon

WASC
003281

Well Record

STATE WELL NO. 2N/13-30G(1)
COUNTY Wasco
APPLICATION NO. G-34

OWNER: Lower Chenoweth Water Dist.


MAILING ADDRESS:

LOCATION OF WELL: Owner's No.

CITY AND STATE:

SW 1/4 NE 1/4 Sec. 30 T. 2 N. R. 13 E. W.M.

Bearing and distance from section or subdivision
corner 190' N. & 696' E. from the center of
Section 30

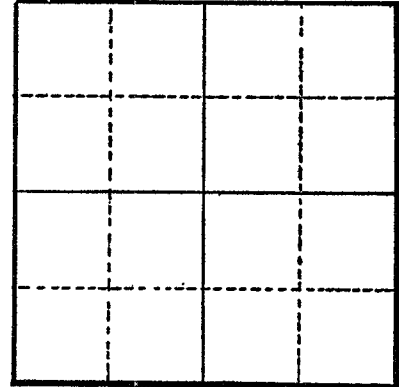

Section 30

Altitude at well

TYPE OF WELL: drilled Date Constructed

Depth drilled 248 Depth cased

CASING RECORD:

8-inch

FINISH:

AQUIFERS:

WATER LEVEL: 112 feet below land surface

PUMPING EQUIPMENT: Type Turbine H.P. 25
Capacity G.P.M.

WELL TESTS:
Drawdown 66 ft. after 2 hours pumping 250 G.P.M.
Drawdown ft. after hours G.P.M.

USE OF WATER Temp. °F., 19

SOURCE OF INFORMATION

DRILLER or DIGGER

ADDITIONAL DATA:

Log Water Level Measurements Chemical Analysis Aquifer Test

REMARKS: