

STATE ENGINEER
Salem, Oregon

WASG
003286

Well Record

STATE WELL NO. 2N/13-30N(1)
COUNTY Wasco
APPLICATION NO. U-219

OWNER: L. M. Sinsabaugh


MAILING ADDRESS: Rt. 4, Box 82

LOCATION OF WELL: Owner's No. Webber No 4

CITY AND STATE: The Dalles, Oregon

SW 1/4 SW 1/4 Sec. 30 T. 2 N. E.
SW R. 13 W.M.

Bearing and distance from section or subdivision corner

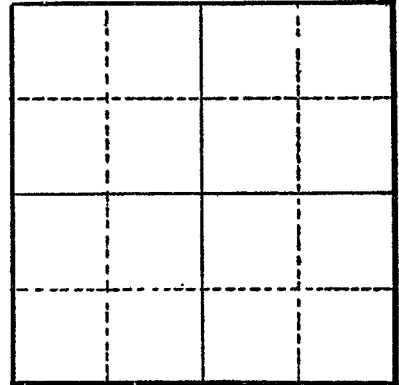

Section

Altitude at well 380'

TYPE OF WELL: drilled Date Constructed 1946

Depth drilled 392 Depth cased 44

CASING RECORD:

8-inch, set to 44 feet

FINISH:

open hole

AQUIFERS:

Basalt (?)

WATER LEVEL:

108 1/2 ft. below land surface, 1946

PUMPING EQUIPMENT: Type Turbine H.P. 15
Capacity G.P.M.

WELL TESTS:

Drawdown ft. after hours G.P.M.
Drawdown ft. after hours G.P.M.

USE OF WATER Irrigation Temp. °F., 19....

SOURCE OF INFORMATION U-219

DRILLER or DIGGER

ADDITIONAL DATA:

Log Water Level Measurements Chemical Analysis Aquifer Test

REMARKS:

Start

STATE ENGINEER
Salem, Oregon

State Well No. 2N/13-30N(1)
County Wasco
Application No. U-219

Well Log

Owner: ~~Ward R. Webber~~ Sinsabaugh Owner's No. 4

Driller: _____ Date Drilled _____

CHARACTER OF MATERIAL	(Feet below land surface)		Thickness (feet)
	From	To	
Soil and clay	0	8	8
Boulders and gravel	8	41	33
Sandstone, dense	41	89	48
Sandstone, soft	89	93	4
Conglomerate	93	124	31
Sandstone, coarse, with pea gravel			
water bearing	124	135	11
Sandstone, coarse and hard	135	138	3
Sandstone, coarse soft	138	161	23
Boulders and gravel bad formation	161	169	8
Sandstone, coarse, water bearing, water level raised about 2 feet	169	185	16
Clay, blue, dark to light, dense	185	231	46
Clay, brown, dense	231	259	28
Conglomerate	259	263	4
Sandstone, dense	263	285	22
Clay, black, some sand	285	319	34
Clay, blue and shale	319	362	43
Shale, blue, caved some during drilling	362	380	18
Clay, blue, dense, very sticky	380	389	9
Clay, blue and coarse black basalt intermingled	389	392	3