

STATE ENGINEER  
Salem, Oregon

WASCO  
003318

# Well Record

STATE WELL NO. 2N/13-32G(1)  
COUNTY Wasco  
APPLICATION NO. U-106

OWNER: Robert Moore

MAILING ADDRESS: Rt. 4

LOCATION OF WELL: Owner's No. 1

CITY AND STATE: The Dalles, Oregon


SW 1/4 NE 1/4 Sec. 32 T. 2 N. 2 S. R. 13 E. W.M.

Bearing and distance from section or subdivision corner

Altitude at well

TYPE OF WELL: drilled Date Constructed

Depth drilled 270 Depth cased

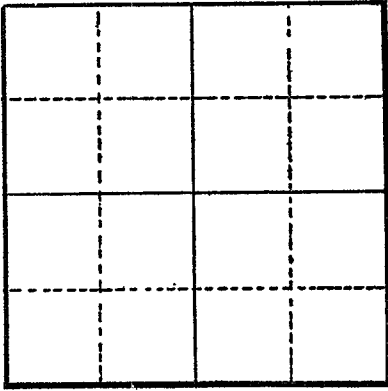

CASING RECORD:

6-inch

FINISH:

AQUIFERS:

WATER LEVEL: 120

PUMPING EQUIPMENT: Type \_\_\_\_\_ H.P. \_\_\_\_\_  
Capacity \_\_\_\_\_ G.P.M.

WELL TESTS:  
Drawdown \_\_\_\_\_ ft. after \_\_\_\_\_ hours \_\_\_\_\_ G.P.M.  
Drawdown \_\_\_\_\_ ft. after \_\_\_\_\_ hours \_\_\_\_\_ G.P.M.

USE OF WATER \_\_\_\_\_ Temp. \_\_\_\_\_ °F. \_\_\_\_\_, 19

SOURCE OF INFORMATION \_\_\_\_\_

DRILLER or DIGGER \_\_\_\_\_  
ADDITIONAL DATA:  
Log \_\_\_\_\_ Water Level Measurements \_\_\_\_\_ Chemical Analysis \_\_\_\_\_ Aquifer Test \_\_\_\_\_

REMARKS: