

STATE ENGINEER
Salem, Oregon

WASCO
003319

Well Record

STATE WELL NO. 2N/13-32G(2)
COUNTY Wasco
APPLICATION NO. U-106

OWNER: Robert Moore


MAILING ADDRESS: Rt. 4

LOCATION OF WELL: Owner's No. _____

CITY AND STATE: The Dalles, Oregon

SW 1/4 NE 1/4 Sec. 32 T. 2 N. 5 R. 13 E. W, W.M.

Bearing and distance from section or subdivision corner _____

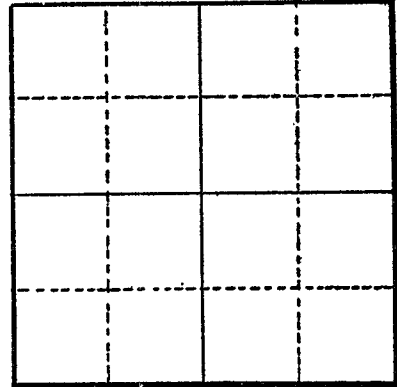

Section _____

Altitude at well _____

TYPE OF WELL: _____ Date Constructed _____

Depth drilled 70 Depth cased _____

CASING RECORD:

4-inch dia.

FINISH:

AQUIFERS:

WATER LEVEL:

PUMPING EQUIPMENT: Type _____ H.P. _____
Capacity _____ G.P.M.

WELL TESTS:
Drawdown _____ ft. after _____ hours _____ G.P.M.
Drawdown _____ ft. after _____ hours _____ G.P.M.

USE OF WATER _____ Temp. _____ °F. _____, 19____

SOURCE OF INFORMATION _____

DRILLER or DIGGER _____

ADDITIONAL DATA:

Log _____ Water Level Measurements _____ Chemical Analysis _____ Aquifer Test _____

REMARKS: