

STATE ENGINEER
Salem, Oregon

WASC
003325

Well Record

STATE WELL NO. 2N/13-32K(3)
COUNTY Wasco
APPLICATION NO. U-56

OWNER: A. D. Rouintree


MAILING
ADDRESS:

LOCATION OF WELL: Owner's No.

CITY AND STATE: The Dalles

NW 1/4 SE 1/4 Sec. 32 T. 2 N. E. S. R. 13 W. W.M.

Bearing and distance from section or subdivision corner

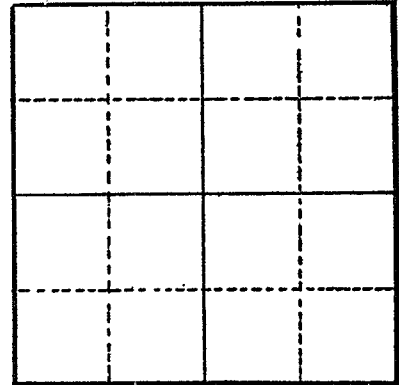

Section 32

Altitude at well

TYPE OF WELL: drilled Date Constructed 1931

Depth drilled 106 Depth cased

CASING RECORD:

FINISH:

AQUIFERS: Water in sandstone(?) at 102 ft.

WATER LEVEL:

76' Below L.S.D. Sept. 1930

PUMPING EQUIPMENT: Type H.P.
Capacity G.P.M.

WELL TESTS:

Drawdown 2 ft. after pumping 20 hours G.P.M.
Drawdown ft. after hours G.P.M.

USE OF WATER Irrigation Temp. °F., 19

SOURCE OF INFORMATION U-56

DRILLER or DIGGER

ADDITIONAL DATA:

Log X Water Level Measurements Chemical Analysis Aquifer Test

REMARKS:

