

150

50

100

150

200

250

300

350

400

450

500

10 X 10 PER INCH

MADE IN U. S. A.

Rat mix
grout

50' BK Basalt

Gray Basalt, hard

50' BK Basalt

Gray Basalt, hard

155
WB. over top
167 Gray Basalt, hard
170 BK Basalt, WB. over top
175

Gray Basalt

217 BK Basalt, Brn, over top

Gray Basalt, hard

320 BK Basalt, Brn, over top


Gray Basalt, hard

416
BK Basalt, porous, over top

455 Gray Basalt, hard

Shut in leakage
Open discharge leakage

0 10 20 30
PPM

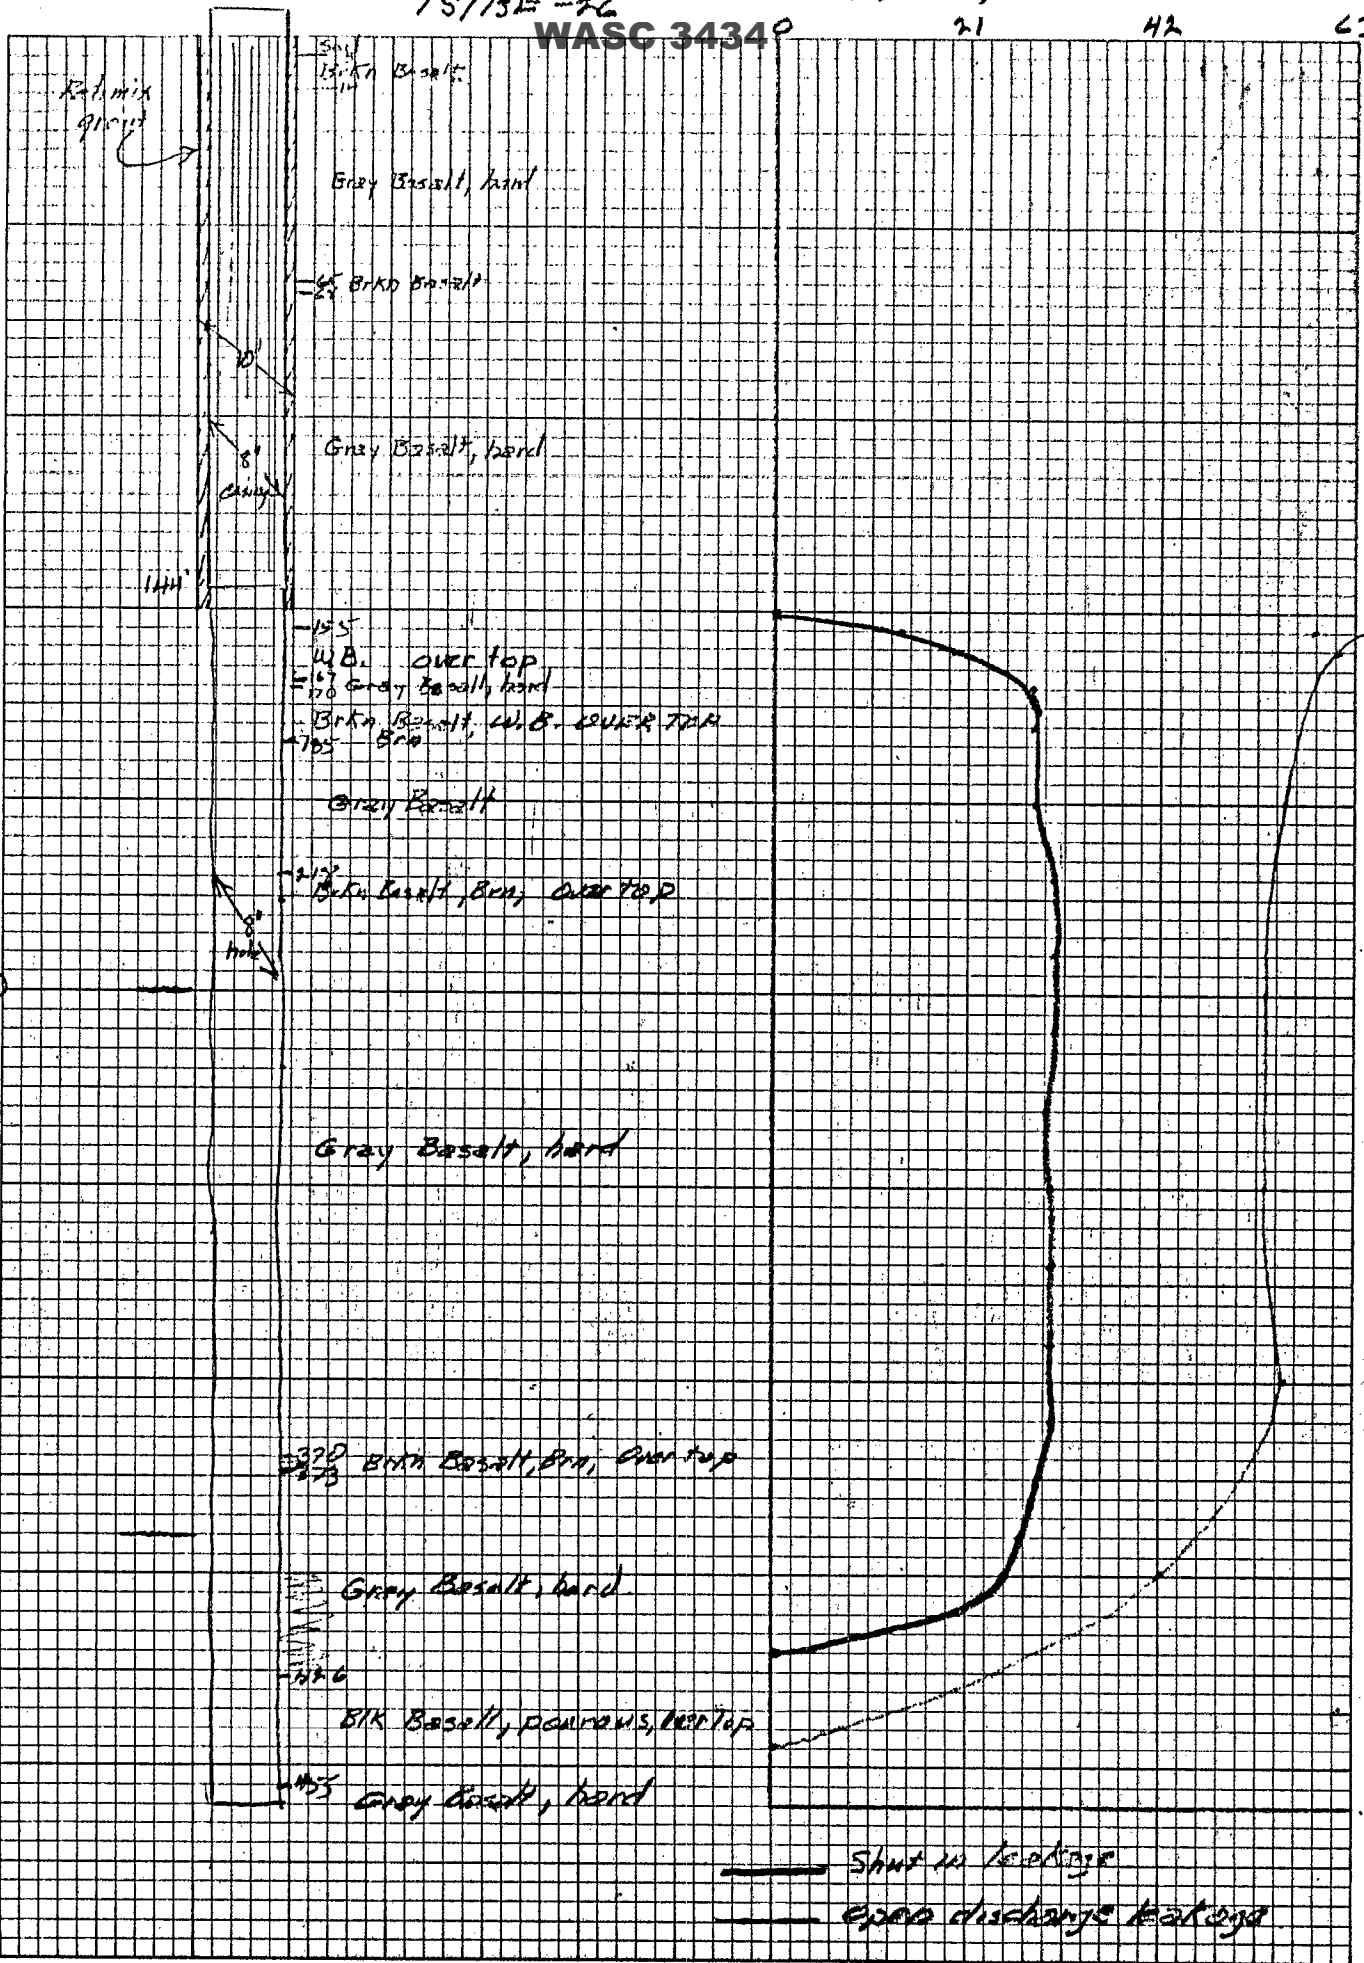



Oregon Water Resources Department
725 Summer Street NE, Suite A
Salem Oregon 97301
(503) 986-0900
www.wrd.state.or.us

Application for
Well ID Number

Do not complete if the well already has a Well I.D Number.

I. OWNER INFORMATION

Current Owner Name (please print): City of Dufur
Mailing Address: P.O. Box 145
City: Dufur OR State: OR Zip: 97021
Mailing Address (to send Well I.D.): SAME
City: State: Zip:

II. WELL INFORMATION (Do not complete this section if the well report is attached.)

Township: 1S (North/South) Range: 13E (East/West) Section: 26
Tax Lot: 4500 County: WASC NE 1/4 SE 1/4
Street Address of Well: City: Dufur
Owner at time the well was constructed, (if known): City of Dufur
If the property had a different street address in the past:

III. GENERAL WELL INFORMATION (Do not complete this section if the well report is attached)

Use of Well (domestic, irrigation, commercial, industrial, monitoring): municipal
Date Well Constructed: 9/11/73 Total Well Depth: 460 Casing Diameter: 10"
Other Information: Lower 60' of well abandoned (WASC 3442)

SUBMITTED BY (please print): Marc Norton
PHONE: 503-986-0841 FAX:

Send application to Oregon Water Resources Department; 725 Summer St NE, Suite A; Salem, Oregon 97301-1266; fax (503) 986-0902. Applications are processed and Well I.D. Numbers are mailed every Wednesday.

For Official Use Only by the Oregon Water Resources Department:
Received Date: Well Log Number: WASC 3434 Well Identification #: 101434
WASC 3442
Alteration