

STATE ENGINEER  
Salem, Oregon

**WASCO Well Record**  
003645

STATE WELL NO. 4/13-10J(1)  
COUNTY Wasco  
APPLICATION NO. U-7

OWNER: Mrs. Agnes Abrahamson


MAILING ADDRESS: \_\_\_\_\_

LOCATION OF WELL: Owner's No. \_\_\_\_\_

CITY AND STATE: \_\_\_\_\_

NE 1/4 SE 1/4 Sec. 10 T. 4 N. S., R. 13 E. W., W.M.

Bearing and distance from section or subdivision corner \_\_\_\_\_

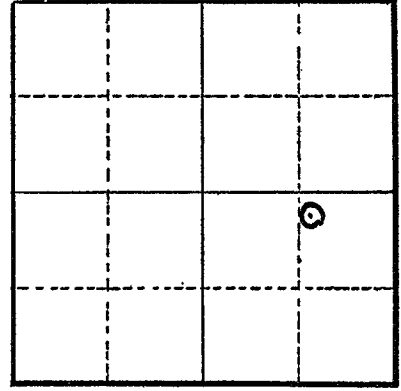

Section 10

Altitude at well \_\_\_\_\_

TYPE OF WELL: Bored Date Constructed 1930

Depth drilled 17 Depth cased \_\_\_\_\_

CASING RECORD:

FINISH:

AQUIFERS:

WATER LEVEL:

PUMPING EQUIPMENT: Type \_\_\_\_\_ H.P. \_\_\_\_\_  
Capacity \_\_\_\_\_ G.P.M.

WELL TESTS:  
Drawdown \_\_\_\_\_ ft. after \_\_\_\_\_ hours \_\_\_\_\_ G.P.M.  
Drawdown \_\_\_\_\_ ft. after \_\_\_\_\_ hours \_\_\_\_\_ G.P.M.

USE OF WATER \_\_\_\_\_ Temp. \_\_\_\_\_ °F. \_\_\_\_\_, 19\_\_\_\_

SOURCE OF INFORMATION \_\_\_\_\_

DRILLER or DIGGER \_\_\_\_\_

ADDITIONAL DATA:  
Log \_\_\_\_\_ Water Level Measurements \_\_\_\_\_ Chemical Analysis \_\_\_\_\_ Aquifer Test \_\_\_\_\_

REMARKS:

