

STATE ENGINEER  
Salem, Oregon

WASC 50427  
WASC 50427  
Well Record

STATE WELL NO. ....  
COUNTY Wasco ..  
APPLICATION NO. ....

OWNER: Tooley Terrace


MAILING ADDRESS: .....

LOCATION OF WELL: Owner's No. #2

CITY AND STATE: .....

NE 1/4 NW 1/4 Sec. 17 T. 2 N. S. R. 13 E. W., W.M.

Bearing and distance from section or subdivision corner .....

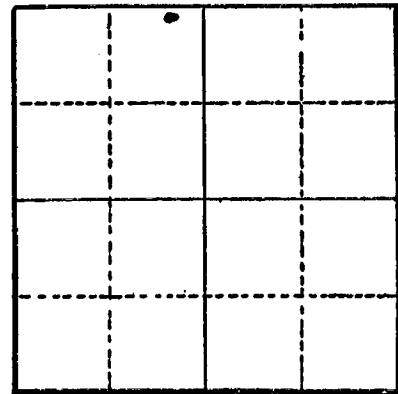

Section 17

Altitude at well .....

TYPE OF WELL: Drilled Date Constructed .....

Depth drilled 33 ft Depth cased .....

CASING RECORD:

8" Casing

FINISH:

AQUIFERS:

WATER LEVEL:

17 ft from top of casing on 3/14/97

PUMPING EQUIPMENT: Type ..... H.P. ....  
Capacity ..... G.P.M. ....

WELL TESTS:  
Drawdown ..... ft. after ..... hours ..... G.P.M.  
Drawdown ..... ft. after ..... hours ..... G.P.M.

USE OF WATER Domestic Water System Temp. .... °F. ...., 19.....

SOURCE OF INFORMATION Richard Pantov,

DRILLER or DIGGER .....

ADDITIONAL DATA:  
Log ..... Water Level Measurements ..... Chemical Analysis ..... Aquifer Test .....

REMARKS:

No well log found for this well log.



Oregon Water Resources Department
725 Summer Street NE, Suite A
Salem Oregon 97301
(503) 986-0900
www.wrd.state.or.us

Application for
Well ID Number

RECEIVED

JAN 25 2010

WATER RESOURCES DEPT
SALEM, OREGON

Do not complete if the well already has a Well I.D Number.

I. OWNER INFORMATION

Current Owner Name (please print): Tooley Water District
Mailing Address: 4727 Simoneli Rd
City: The Dalles State: OR Zip: 97058
Mailing Address (to send Well I.D.): same as above
City: State: Zip:

II. WELL INFORMATION (Do not complete this section if the well report is attached.)

Township: 2 (North/South) Range: 13 (East/West) Section: 17 BA
Tax Lot: 100 County: Wasco NE 1/4 NW 1/4
Street Address of Well: 4875 Hwy 30W City: The Dalles
Owner at time the well was constructed, (if known): Fred V Tooley
If the property had a different street address in the past:

III. GENERAL WELL INFORMATION (Do not complete this section if the well report is attached)

Use of Well (domestic, irrigation, commercial, industrial, monitoring): Group Domestic
Date Well Constructed: Total Well Depth: Casing Diameter:
Other Information:

SUBMITTED BY (please print): Robert Wood (Dist 3 watermaster)
PHONE: 541-506-2650 FAX: 541-506-2651

Send application to Oregon Water Resources Department; 725 Summer St NE, Suite A; Salem, Oregon 97301-1266; fax (503) 986-0902. Applications are processed and Well I.D. Numbers are mailed every Wednesday.

For Official Use Only by the Oregon Water Resources Department.
Received Date: Well Log Number: WASC 3229 Well Identification #: L-94687
WASC 50427