

STATE OF OREGON  
WATER SUPPLY WELL REPORT

WELL ID # L 156330

(as required by ORS 537.765)

(START CARD) # 148846

Instructions for completing this report are on the last page of this form

(1) OWNER: Well Number: \_\_\_\_\_  
 Name Mal Omega & Gary & Ann Copper  
 Address 2965 Dry Hollow Rd.  
 City The Dalles State OR Zip 97058

(2) TYPE OF WORK:  
 New Well  Deepening  Alteration (repair/recondition)  Abandonment

(3) DRILL METHOD:  
 Rotary Air  Rotary Mud  Cable  Auger  
 Other

(4) PROPOSED USE:  
 Domestic  Community  Industrial  Irrigation  
 Thermal  Injection  Livestock  Other

(5) BORE HOLE CONSTRUCTION:  
 Special Construction approval  Yes  No Depth of Completed Well 704 ft.  
 Explosives used  Yes  No Type \_\_\_\_\_ Amount \_\_\_\_\_

HOLE		SEAL		Amount	
Diameter	From To	Material	From To	sacks or pounds	
6"	575 704				

How was seal placed: Method  A  B  C  D  E  
 Other N/A  
 Backfill placed from \_\_\_\_\_ ft. to \_\_\_\_\_ ft. Material \_\_\_\_\_  
 Gravel placed from \_\_\_\_\_ ft. to \_\_\_\_\_ ft. Size of gravel \_\_\_\_\_

(6) CASING/LINER:

	Diameter	From	To	Gauge	Steel	Plastic	Welded	Threaded
Casing:					<input type="checkbox"/>	<input type="checkbox"/>	<input type="checkbox"/>	<input type="checkbox"/>
Liner:					<input type="checkbox"/>	<input type="checkbox"/>	<input type="checkbox"/>	<input type="checkbox"/>

Final location of shoe(s)

(7) PERFORATIONS/SCREENS:

From	To	Slot size	Number	Diameter	Tel./pipe size	Casing	Liner
						<input type="checkbox"/>	<input type="checkbox"/>

(8) WELL TESTS: Minimum testing time is 1 hour  
 Pump  Baller  Air  Flowing Artesian

Yield gal/min	Drawdown	Drill stem at	Time
210		575	2 hr.

Temperature of Water 78 Depth Artesian Flow found \_\_\_\_\_  
 Was a water analysis done?  Yes By whom \_\_\_\_\_  
 Did any strata contain water not suitable for intended use?  Too little  
 Salty  Muddy  Odor  Colored  Other \_\_\_\_\_  
 Depth of strata: \_\_\_\_\_

(9) LOCATION OF WELL by legal description:  
 County Wasco Latitude 31.896 Longitude 12.544  
 Township 1N N or S. Range 13E E or W. of WM.  
 Section 33 NW 1/4 NW 1/4  
 Tax lot 4200 Lot \_\_\_\_\_ Block \_\_\_\_\_ Subdivision \_\_\_\_\_  
 Street Address of Well (or nearest address) 3465 Three Mile Rd.  
The Dalles, Or.

(10) STATIC WATER LEVEL:  
240 ft. below land surface. Date 03/13/2003  
 Artesian pressure \_\_\_\_\_ lb. per square inch. Date \_\_\_\_\_

(11) WATER BEARING ZONES:


Depth at which water was first found 670

From	To	Estimated Flow Rate	SWL
670	699	210	240

(12) WELL LOG: Ground elevation 1334

Material	From	To	SWL
Basalt Med. Black	575	584	
Basalt Soft Black	584	670	
Basalt Broken Soft Black	670	699	
Basalt Hard Gray	699	704	240

We started with about 25 GPM @ 71 deg. SWL @ 73 Ft. Hole 575 Ft. 8". We drilled 6" down to 704 ft. and increased the flow. we pulled out set an 8" plug to 575 ft. put in 5 yds. of sand cement let set for three days drilled out cement and with the upper water shut off. We drilled out the 8" wooden plug. Flow was air tested for 2 hrs. @ 210 GPM and 78 deg.

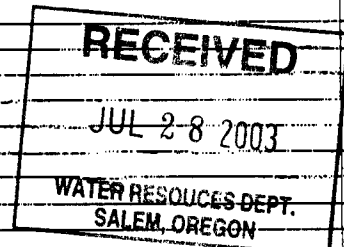

Date started 02/18/2003 Completed 03/11/2003

(unbonded) Water Well Constructor Certification:  
 I certify that the work I performed on the construction, alteration, or abandonment of this well is in compliance with Oregon water supply well construction standards. Materials used and information reported above are true to my best knowledge and belief.

Signed \_\_\_\_\_ WWC Number \_\_\_\_\_ Date \_\_\_\_\_

(bonded) Water Well Constructor Certification:  
 I accept responsibility for the construction, alteration, or abandonment work performed on this well during the construction dates reported above. All work performed during this time is in compliance with Oregon water supply well construction standards. This report is to the best of my knowledge and belief.

Signed Charles Austin WWC Number 790 Date 03/13/2003

e✓ 4-30-04



# Oregon

Theodore R. Kulongoski, Governor

Water Resources Department  
North Mall Office Building  
725 Summer Street NE, Suite A  
Salem, OR 97301-1271  
503-986-0900  
FAX 503-986-0904

April 26, 2004

Charles Austin #790  
3393 Sandlin Road  
The Dalles, OR 97058

RE: Special Standard Request - Omeg Well

Dear Mr. Austin:

The special standard request you submitted for start card 148846 is approved. Your special standard request form is enclosed for your information.

OAR 690-200-0021 requires the well constructor to request and receive approval prior to completion of the well. Please note, in the future, **no special standards will be granted for after-the-fact requests.**

The Well Construction Standards serve to protect ground water resources. By approving and issuing this special construction standard, the Oregon Water Resources Department is not representing that a well constructed in accordance with this condition will maintain structural integrity or that it meets engineering standards. The well constructor and/or landowner is responsible for ensuring that a well constructed in a manner that protects the ground water resources as required under Oregon Administrative Rules 690-200 through 690-240.

If you have any questions concerning this letter, I may be contacted at (503) 986-0852 or by e-mail at: [Juno.G.Pandian@ wrd.state.or.us](mailto:Juno.G.Pandian@ wrd.state.or.us).

Sincerely,

JUNO PANDIAN, Manager  
Enforcement Section

enclosure

cc: Brian Mayer, Well Inspector

This is a final order in other than a contested case. This order is subject to judicial review under ORS 183.484. Any petition for judicial review of the order must be filed within the 60 day time period specified by ORS 183.484(2). Pursuant to ORS 536.075 and OAR 137-004-0080 and OAR 690-01-0005 you may either petition for judicial review or petition the Director for reconsideration of this order.