

STATE OF OREGON  
**WATER SUPPLY WELL REPORT**  
 (as required by ORS 537.765)

WELL I.D. # L 54988  
 START CARD # 123775

Instructions for completing this report are on the last page of this form.

(1) **LAND OWNER** Well Number \_\_\_\_\_  
 Name Chenoweth PUD WATER  
 Address P.O. Box 870 (2312 W 5th St)  
 City THE DALLES State OR Zip 97058

(2) **TYPE OF WORK**  
 New Well  Deepening  Alteration (repair/recondition)  Abandonment

(3) **DRILL METHOD:**  
 Rotary Air  Rotary Mud  Cable  Auger  
 Other \_\_\_\_\_

(4) **PROPOSED USE:**  
 Domestic  Community  Industrial  Irrigation  
 Thermal  Injection  Livestock  Other \_\_\_\_\_

(5) **BORE HOLE CONSTRUCTION:**  
 Special Construction approval  Yes  No Depth of Completed Well 467 ft.  
 Explosives used  Yes  No Type \_\_\_\_\_ Amount \_\_\_\_\_

HOLE			SEAL			
Diameter	From	To	Material	From	To	Sacks or pounds

How was seal placed: Method  A  B  C  D  E  
 Other \_\_\_\_\_

Backfill placed from \_\_\_\_\_ ft. to \_\_\_\_\_ ft. Material \_\_\_\_\_  
 Gravel placed from \_\_\_\_\_ ft. to \_\_\_\_\_ ft. Size of gravel \_\_\_\_\_

(6) **CASING/LINER:**

	Diameter	From	To	Gauge	Steel	Plastic	Welded	Threaded
Casing:	<u>6"</u>	<u>+1</u>	<u>400</u>	<u>.250</u>	<input checked="" type="checkbox"/>	<input type="checkbox"/>	<input checked="" type="checkbox"/>	<input type="checkbox"/>
Liner:	<u>6"</u>	<u>+1</u>	<u>400</u>	<u>.250</u>	<input checked="" type="checkbox"/>	<input type="checkbox"/>	<input checked="" type="checkbox"/>	<input type="checkbox"/>

Drive Shoe used  Inside  Outside  None  
 Final location of shoe(s) 400'

(7) **PERFORATIONS/SCREENS:**  
 Perforations Method \_\_\_\_\_  
 Screens Type \_\_\_\_\_ Material \_\_\_\_\_

From	To	Slot size	Number	Diameter	Tele/pipe size	Casing	Liner
						<input type="checkbox"/>	<input type="checkbox"/>
						<input type="checkbox"/>	<input type="checkbox"/>

(8) **WELL TESTS: Minimum testing time is 1 hour**  
 Pump  Bailer  Air  Flowing  Artesian  
 Yield gal/min 30 gal Drawdown NONE Drill stem at \_\_\_\_\_ Time 1 hr.

Temperature of water 58 Depth Artesian Flow Found \_\_\_\_\_  
 Was a water analysis done  Yes  No By whom \_\_\_\_\_  
 Did any strata contain water not suitable for intended use?  Too little  
 Salty  Muddy  Odor  Colored  Other \_\_\_\_\_  
 Depth of strata: \_\_\_\_\_

(9) **LOCATION OF WELL by legal description:**  
 County Wasco Latitude \_\_\_\_\_ Longitude \_\_\_\_\_  
 Township L  N or S Range 13  or W. WM.  
 Section 5 UE 1/4 SW 1/4  
 Tax Lot 1800 Lot \_\_\_\_\_ Block \_\_\_\_\_ Subdivision \_\_\_\_\_  
 Street Address of Well (or nearest address) 1976 CHERRY HEIGHTS

(10) **STATIC WATER LEVEL:**  
329 ft. below land surface. Date 7-20-2003  
 Artesian pressure \_\_\_\_\_ lb. per square inch Date \_\_\_\_\_


(11) **WATER BEARING ZONES:**

Depth at which water was first found \_\_\_\_\_

From	To	Estimated Flow Rate	SWL

(12) **WELL LOG:**  
 Ground Elevation \_\_\_\_\_

Material	From	To	SWL
<u>Rap liner</u>			
<u>Below Clay</u>			
<u>Layer 380</u>			
<u>to 400'</u>			
<u>Drilled the</u>			
<u>Bottom out</u>			
<u>to 467'</u>			
<u>Cleaned out.</u>			

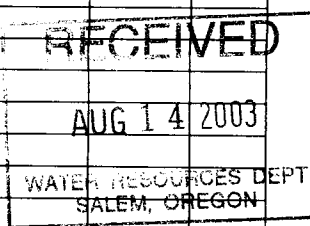

Date started 7-20 Completed 7-23-2003

(unbonded) Water Well Constructor Certification:  
 I certify that the work I performed on the construction, alteration, or abandonment of this well is in compliance with Oregon water supply well construction standards. Materials used and information reported above are true to the best of my knowledge and belief.  
 Signed Jody Han WWC Number 1669  
 Date 8-05-2003

(bonded) Water Well Constructor Certification:  
 I accept responsibility for the construction, alteration, or abandonment work performed on this well during the construction dates reported above. All work performed during this time is in compliance with Oregon water supply well construction standards. This report is true to the best of my knowledge and belief.  
 Signed Jody Han WWC Number 1669  
 Date 8-05-2003