

STATE OF OREGON
WATER SUPPLY WELL REPORT
(as required by ORS 537.765 & OAR 690-205-0210)

WELL LABEL # L 6630 66330
START CARD # 175038

(1) LAND OWNER Owner Well I.D. 4
First Name Last Name
Company CITY OF MOSIER
Address PO BOX 465
City MOSIER State OR Zip 97040

(2) TYPE OF WORK [X] New Well [] Deepening [] Conversion
[] Alteration (repair/recondition) [] Abandonment

(3) DRILL METHOD
[X] Rotary Air [] Rotary Mud [] Cable [] Auger [] Cable Mud
[] Reverse Rotary [] Other

(4) PROPOSED USE [] Domestic [] Irrigation [X] Community
[] Industrial/ Commercial [] Livestock [] Dewatering
[] Thermal [] Injection [] Other

(5) BORE HOLE CONSTRUCTION Special Standard [] (Attach copy)
Depth of Completed Well 498 ft.

Table with columns: Dia, From, To, Material, SEAL, From, To, Amt, lbs. Rows include Bentonite Chips, Cement, etc.

How was seal placed: Method [] A [X] B [X] C [] D [] E
Backfill placed from ft. to ft. Material
Filter pack from ft. to ft. Material Size
Explosives used: [] Yes Type Amount

(6) CASING/LINER table with columns: Casing, Liner, Dia, From, To, Gauge, Stl, Plstc, Wld, Thrd

Shoe [] Inside [] Outside [] Other Location of shoe(s)
Temp casing [] Yes Dia From To

(7) PERFORATIONS/SCREENS
Perforations Method factory cut
Screens Type Material

Table with columns: Perf/ Screen, Casing/ Liner, Dia, From, To, Scrm/slot width, Slot length, # of slots, Tele/ pipe size

(8) WELL TESTS: Minimum testing time is 1 hour
[] Pump [] Bailer [X] Air [] Flowing Artesian
Yield gal/min Drawdown Drill stem/Pump depth Duration (hr)

Table with columns: From, To, Description, Amount, Units. Includes lab analysis results.

(9) LOCATION OF WELL (legal description)
County WASCO Twp 2 N N/S Range 11 E E/W WM
Sec 12 NE 1/4 of the NE 1/4 Tax Lot 400
Tax Map Number Lot
Lat ° 0 ' " or DMS or DD
Long ° 0 ' " or DMS or DD
[] Street address of well [] Nearest address

951 MOSIER CREEK RD

(10) STATIC WATER LEVEL
Date SWL(psi) + SWL(ft)
Existing Well / Predeepening
Completed Well
Flowing Artesian? [X] Dry Hole? []

WATER BEARING ZONES table with columns: SWL Date, From, To, Est Flow, SWL(psi), + SWL(ft)

(11) WELL LOG table with columns: Material, From, To, Ground Elevation

Date Started 07-10-2006 Completed 08-04-2006

(unbonded) Water Well Constructor Certification
I certify that the work I performed on the construction, deepening, alteration, or abandonment of this well is in compliance with Oregon water supply well construction standards.


License Number Date
Password : (if filing electronically)
Signed

(bonded) Water Well Constructor Certification
I accept responsibility for the construction, deepening, alteration, or abandonment work performed on this well during the construction dates reported above.

License Number 1293 Date 08-21-2006
Password : (if filing electronically) *****
Signed
Contact Info (optional) Person Pump & Well Drilling 509-773-4085

RECEIVED

Map of well

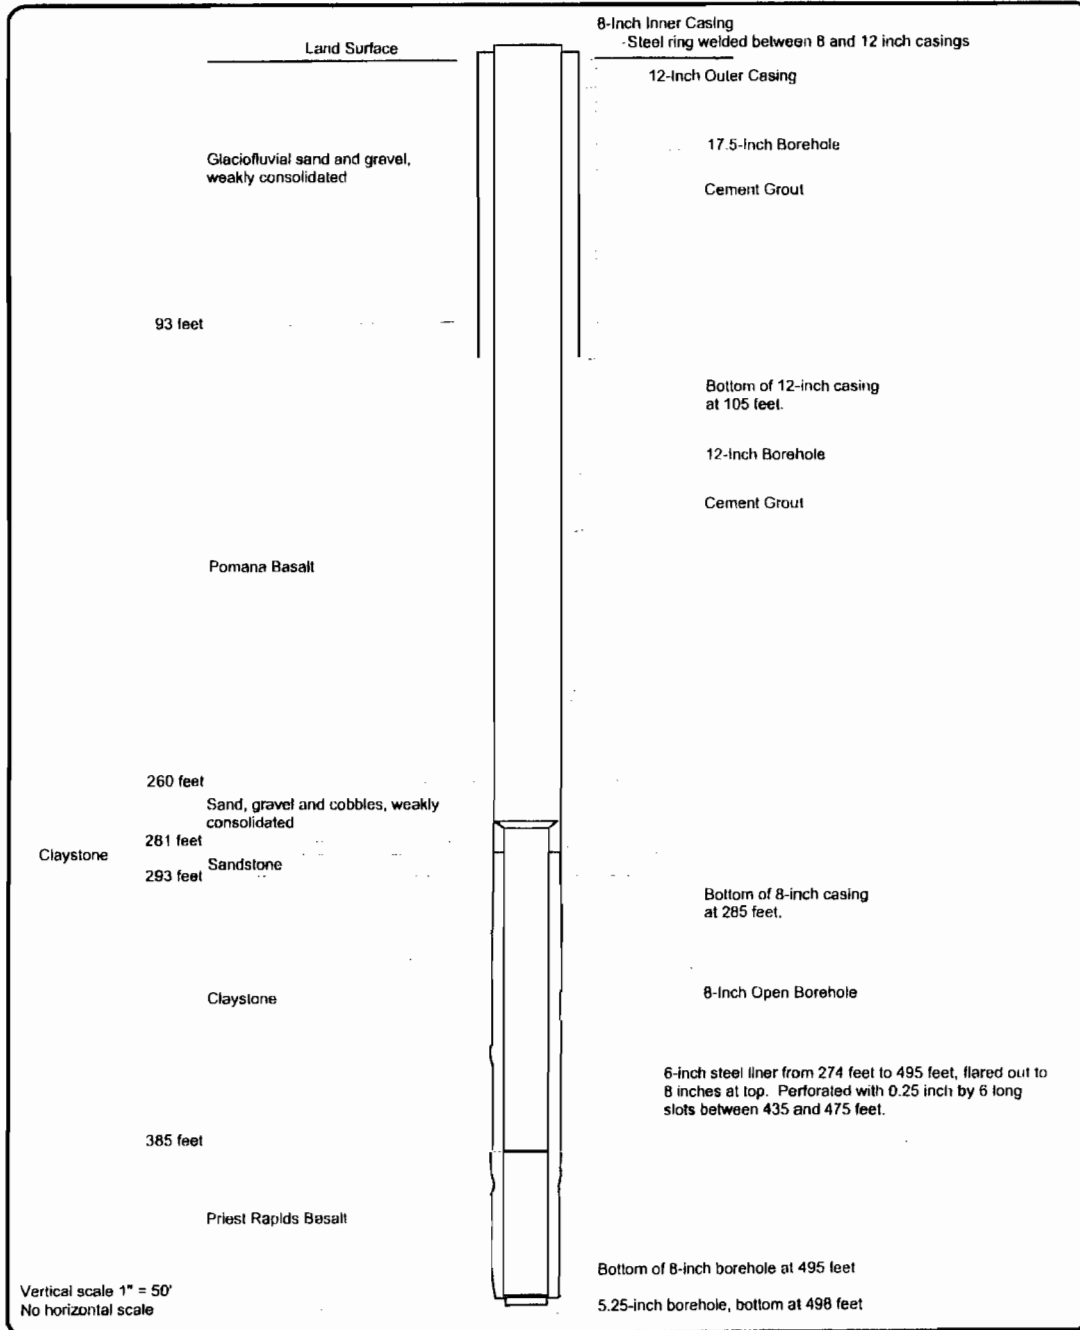

Ground water & Environmental Consultants
Mark Yinger Associates
 4865 Baseline Road, Parkdale OR, 97041 - 541-352-6015

City of Mosier Water Improvement Project
 Well #4 As-Built

RECEIVED
 AUG 28 2006
 WATER RESOURCES DEPT
 SALEM, OREGON