

STATE OF OREGON
WATER SUPPLY WELL REPORT
(as required by ORS 537.765 & OAR 690-205-0210)

04-12-2010

WELL LABEL # L 98280

START CARD # 1009136

(1) LAND OWNER Owner Well I.D.
First Name TYLER Last Name STONE
Company WASCOCO FAIRGROUNDS
Address 57678 FAIRGROUNDS ROAD
City TYGH VALLEY State OR Zip 97063

(2) TYPE OF WORK [X] New Well [] Deepening [] Conversion
[] Alteration (repair/recondition) [] Abandonment

(3) DRILL METHOD
[X] Rotary Air [] Rotary Mud [] Cable [] Auger [] Cable Mud
[] Reverse Rotary [] Other

(4) PROPOSED USE [] Domestic [] Irrigation [X] Community
[X] Industrial/ Commercial [] Livestock [] Dewatering
[] Thermal [] Injection [] Other

(5) BORE HOLE CONSTRUCTION Special Standard [] Attach copy
Depth of Completed Well 131.00 ft.

Table with columns: Dia, From, To, Material, SEAL, From, To, Amt, sacks/lbs. Rows include Bentonite and Cement.

How was seal placed: Method [X] A [] B [] C [] D [] E

[] Other POURED

Backfill placed from ft. to ft. Material

Filter pack from ft. to ft. Material Size

Explosives used: [] Yes Type Amount

(6) CASING/LINER Table with columns: Casing, Liner, Dia, From, To, Gauge, Stl, Plstc, Wld, Thrd. Includes graphical symbols for casing types.

Shoe [] Inside [] Outside [] Other Location of shoe(s)

Temp casing [] Yes Dia From To

(7) PERFORATIONS/SCREENS
Perforations Method
Screens Type Material

Table with columns: Perf/S, Casing/Screen, Dia, From, To, Scrn/slot width, Slot length, # of slots, Tele/pipe size.

(8) WELL TESTS: Minimum testing time is 1 hour

[] Pump [] Bailer [X] Air [] Flowing Artesian
Yield gal/min Drawdown Drill stem/Pump depth Duration (hr)

Table with columns: Yield gal/min, Drawdown, Drill stem/Pump depth, Duration (hr). Row 1: 70, 130, 1.

Temperature 54 °F Lab analysis [X] Yes By CITY OF THE DALLES

Water quality concerns? [X] Yes (describe below)

Table with columns: From, To, Description, Amount, Units. Row 1: 8, 88, Bacterial.

(9) LOCATION OF WELL (legal description)
County Wasco Twp 4.00 S N/S Range 13.00 E E/W WM
Sec 5 SE 1/4 of the NW 1/4 Tax Lot 400
Tax Map Number Lot
Lat 0 ' " or DMS or DD
Long 0 ' " or DMS or DD
[] Street address of well [] Nearest address
57678 FAIRGROUNDS ROAD TYGH VALLEY OR. 97063

(10) STATIC WATER LEVEL Date SWL(psi) + SWL(ft)
Existing Well / Predeepening
Completed Well 03-16-2010 15
Flowing Artesian? [] Dry Hole? []

WATER BEARING ZONES Table with columns: SWL Date, From, To, Est Flow, SWL(psi), + SWL(ft). Rows include 01-02-2010 and 03-14-2010.

(11) WELL LOG Table with columns: Material, From, To. Includes SOIL, SAND AND GRAVEL, BOULDERS AND GRAVEL, SANDSTONE HARD FINE BRN, SANDSTONE COARSE BRN, SANDSTONE BRN WITH CLAYSTONE TAN, SANDSTONE HARD FINE BRN.

Date Started 01-02-2010 Completed 03-16-2010

(unbonded) Water Well Constructor Certification
I certify that the work I performed on the construction, deepening, alteration, or abandonment of this well is in compliance with Oregon water supply well construction standards. Materials used and information reported above are true to the best of my knowledge and belief.


License Number Date
Electronically Filed
Signed

(bonded) Water Well Constructor Certification
I accept responsibility for the construction, deepening, alteration, or abandonment work performed on this well during the construction dates reported above. All work performed during this time is in compliance with Oregon water supply well construction standards. This report is true to the best of my knowledge and belief.

License Number 790 Date 04-12-2010
Electronically Filed
Signed CHARLES W AUSTIN (E-filed)
Contact Info (optional)

WASC 51774

EXEMPT USE WELL LOCATION MAP

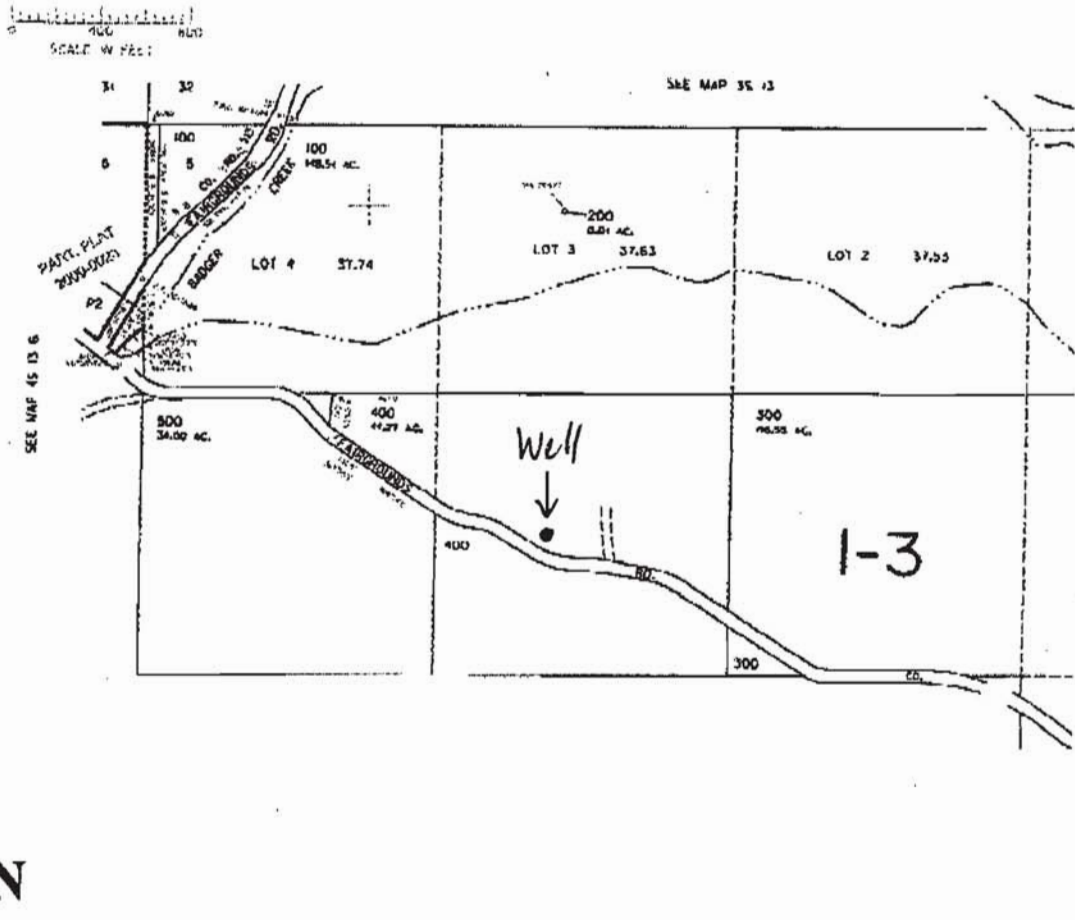

Wasco County

Assessor Map Reference Number: **4S 13E 5 SENW Tax Lot 400**

Street Address of Well, if Available: **57678 Fairgrounds Road, Tygh Valley, OR.** Well Log # **WASC 51774.** Well Label # **L 98280.** (Please Locate Well and Indicate distance From Property or Survey Corner, See Attached Sample Well Location Map.). You may also locate your well using our exempt use well mapping tool on our website at [www.wrd.state.or.us/owrd/exempt use 788 info.shtml](http://www.wrd.state.or.us/owrd/exempt_use_788_info.shtml) or by contacting the Exempt Use Well Program Coordinator at 503 986-0861.

LAND OWNER SUBMITTED MAP

PAPER MAP NOT TO SCALE

RECEIVED

APR 26 2010

**WATER RESOURCES DEPT
SALEM, OREGON**