

STATE ENGINEER  
Salem, Oregon

WASH Well Record  
010017

STATE WELL NO. W-19B(1)  
COUNTY Wash.  
APPLICATION NO. G.P.-478

OWNER: Louis R. Malensky

MAILING ADDRESS: Rt. 4


LOCATION OF WELL: Owner's No. #4

CITY AND STATE: Hillsboro, Ore.

NW 1/4 NE 1/4 Sec. 19 T. 1 S., R. 2 W., W.M.

Bearing and distance from section or subdivision

corner S. 54°56' E. 2400.09 ft.  
from N.E. cor. N.C. Richardson  
DLC #63

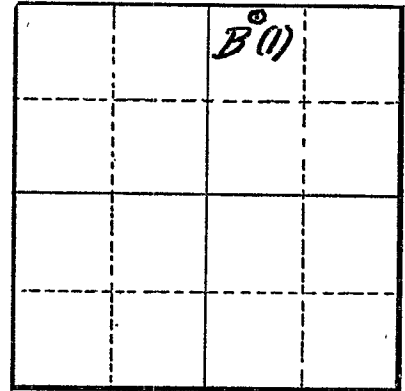

Section 19

Altitude at well 175

TYPE OF WELL: drilled Date Constructed Fall '49

Depth drilled 65 Depth cased 65

CASING RECORD:

6 inch

FINISH:

AQUIFERS:

WATER LEVEL:

3

PUMPING EQUIPMENT: Type Centrifugal H.P. 5  
Capacity \_\_\_\_\_ G.P.M.

WELL TESTS:

Drawdown \_\_\_\_\_ ft. after \_\_\_\_\_ hours \_\_\_\_\_ G.P.M.  
Drawdown \_\_\_\_\_ ft. after \_\_\_\_\_ hours \_\_\_\_\_ G.P.M.

USE OF WATER irrigation-71.4Ac Temp. \_\_\_\_\_ °F., 19\_\_\_\_

SOURCE OF INFORMATION G.P.-478

DRILLER or DIGGER Art Gaunt; Aloha, Ore.

ADDITIONAL DATA:

Log no Water Level Measurements \_\_\_\_\_ Chemical Analysis \_\_\_\_\_ Aquifer Test \_\_\_\_\_

REMARKS: