

STATE ENGINEER
Salem, Oregon

WASH

010036

Well Record

STATE WELL NO. 1S/2W 20P(1)
COUNTY Washington
APPLICATION NO.

Carl A. Peters


OWNER: John Kamna

MAILING ADDRESS:
CITY AND STATE:

LOCATION OF WELL: Owner's No.

..... 1/4 1/4 Sec. T. N. S., R. E. W., W.M.

Bearing and distance from section or subdivision corner

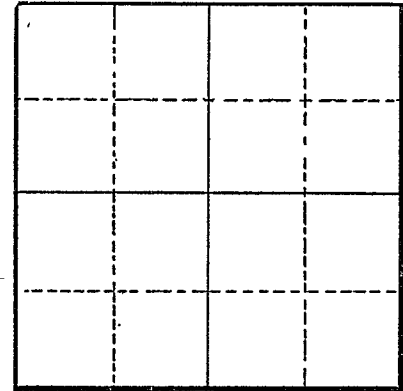

Section

Altitude at well 180 ft.

TYPE OF WELL: drilled Date Constructed

Depth drilled 450 ft. Depth cased 140 ft.

CASING RECORD: 10 inch

FINISH:

AQUIFERS: Basalt from 140 to 450 ft.

WATER LEVEL: 11 ft. below land surface.

PUMPING EQUIPMENT: Type N H.P.
Capacity G.P.M.

WELL TESTS:
Drawdown ft. after hours G.P.M.
Drawdown ft. after hours G.P.M.

USE OF WATER irrigation Temp. °F., 19

SOURCE OF INFORMATION USGS

DRILLER or DIGGER

ADDITIONAL DATA:

Log Water Level Measurements Chemical Analysis Aquifer Test

REMARKS: Reported 140 ft. of clay above aquifer; test pumped at 100 gpm with 150 ft. of drawdown.