

STATE ENGINEER  
Salem, Oregon

WASH

Well Record

STATE WELL NO. 1/2W-21B  
COUNTY WASHINGTON  
APPLICATION NO. GR-1353


010048

OWNER: Emmett E. Woodward & Amy E. Woodward MAILING ADDRESS: Rt. 2, Box 259 C

LOCATION OF WELL: Owner's No. CITY AND STATE: Hillsboro, Oregon

NW 1/4 NE 1/4 Sec. 21 T. 1 N, R. 2 W., W.M.

Bearing and distance from section or subdivision corner S. 85° 50' W. 1451'

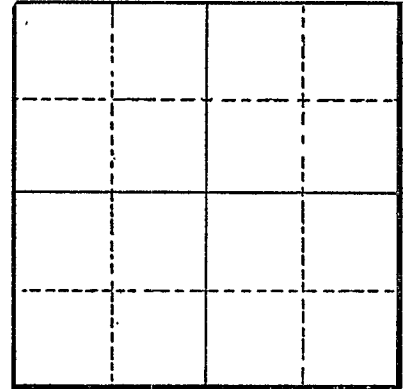

Section

Altitude at well

TYPE OF WELL: Drilled Date Constructed 1952

Depth drilled 211 Depth cased 211

CASING RECORD:

- 8-inch
- 6-inch

FINISH:

AQUIFERS:

Sand, clay and water

WATER LEVEL:

15-inches above L.S.D.

PUMPING EQUIPMENT: Type Cook Jet H.P. 1/2  
Capacity 15 G.P.M.

WELL TESTS:

Drawdown 32 ft. after hours Pumping 30 G.P.M.  
Drawdown ft. after hours G.P.M.

USE OF WATER irrigation Temp. °F., 19

SOURCE OF INFORMATION GR-2539

DRILLER or DIGGER

ADDITIONAL DATA:

Log X Water Level Measurements Chemical Analysis Aquifer Test

REMARKS: Fine yellow sand 22 22  
Blue clay 76 98  
Fine blue sand 29 127  
Blue clay 38 165  
Yellow clay 33 198  
Blue sand also water 13 211