

STATE ENGINEER
Salem, Oregon

WASH
010101

Well Record

STATE WELL NO. 1/2W-22H
COUNTY Washington
APPLICATION NO. GR-1551

GR-1495

OWNER: Albert Rupprecht


MAILING ADDRESS: Rt. 2, Box 775

LOCATION OF WELL: Owner's No.

CITY AND STATE: Beaverton, Oregon

SE 1/4 NE 1/4 Sec. 22 T. 1 S., R. 2 W., W.M.

Bearing and distance from section or subdivision corner S. 27° W. 2000' from NE cor. Sec. 22

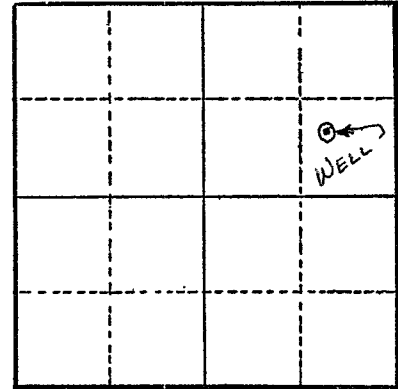

Section 22

Altitude at well 250'

TYPE OF WELL: Drilled Date Constructed 1952

Depth drilled 142' Depth cased 142'

CASING RECORD:

- 8" from 0 to 88 ft.
- 6" from 88 to 128 ft.
- 4" from 128 to 142 ft.

FINISH:

Slotted perforations: from 128 to 142 ft.

AQUIFERS:

WATER LEVEL:

120'

PUMPING EQUIPMENT: Type Berkeley jet H.P. 3

Capacity 50 G.P.M.

WELL TESTS:

Drawdown 120 ft. after _____ hours 50 G.P.M.

Drawdown _____ ft. after _____ hours _____ G.P.M.

USE OF WATER Irrigation Temp. °F. 19

SOURCE OF INFORMATION GR Record

DRILLER or DIGGER Lee Barton

ADDITIONAL DATA:

Log N.A. Water Level Measurements _____ Chemical Analysis _____ Aquifer Test _____

REMARKS:

Irrigation of 20.8 acres.