

STATE ENGINEER  
Salem, Oregon

WASH  
010114

# Well Record

STATE WELL NO. 1/2W-23  
COUNTY Washington  
APPLICATION NO. GR-333

OWNER: John and Joe Santoro


MAILING ADDRESS: Rt 2, Box 768

LOCATION OF WELL: Owner's No. #1

CITY AND STATE: Beaverton, Oregon

SE 1/4 SW 1/4 Sec. 23 T. 1 S., R. 2 W., W.M.

Bearing and distance from section or subdivision corner N 0° 15' W 733.17 feet from the quarter corner on south line of section 23.

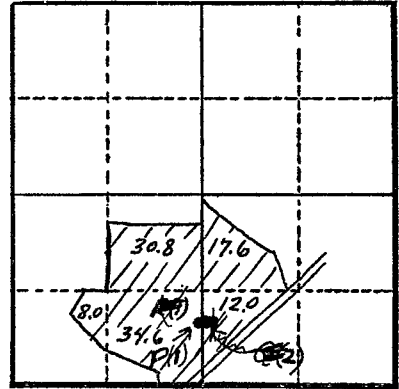

Section 23

Altitude at well 195 feet Interpolated

TYPE OF WELL: Drilled Date Constructed 10-14-52

Depth drilled 127 Depth cased 32

### CASING RECORD:

12 inch steel casing from 0 to 32 feet.

### FINISH:

None

### AQUIFERS:

rock at 93 to 113 feet.

### WATER LEVEL:

Flowing well 20 gpm - 1 lb. psi. shut in pressure.

PUMPING EQUIPMENT: Type Byron-Jackson Turbine H.P. 20  
Capacity 220 G.P.M.

### WELL TESTS:

Drawdown 110 ft. after 200 hours pumping G.P.M.  
Drawdown \_\_\_\_\_ ft. after \_\_\_\_\_ hours \_\_\_\_\_ G.P.M.

USE OF WATER Irrigation 103 acres Temp. \_\_\_\_\_ °F. \_\_\_\_\_, 19.

SOURCE OF INFORMATION Reg. Statement GR-333

DRILLER or DIGGER A.M. Johnson Drilling Co. Aloha, Oregon

### ADDITIONAL DATA:

Log yes Water Level Measurements \_\_\_\_\_ Chemical Analysis \_\_\_\_\_ Aquifer Test \_\_\_\_\_

### REMARKS:

USGS # 1/2W-23 Q(2)

