

STATE ENGINEER
Salem, Oregon

WASH

Well Record

STATE WELL NO. 1/2W-23B
COUNTY Washington
APPLICATION NO. GR-1460

010137

GR-1409

OWNER: C. D. Walker & H. W. Shaper


MAILING ADDRESS: Rt. 2

LOCATION OF WELL: Owner's No. #1

CITY AND STATE: Beaverton, Oregon

NW 1/4 NE 1/4 Sec. 23 T. 1 S., R. 2 W., W.M.

Bearing and distance from section or subdivision corner S. 63° E. 1330' from N 1/4 cor. Sec. 23

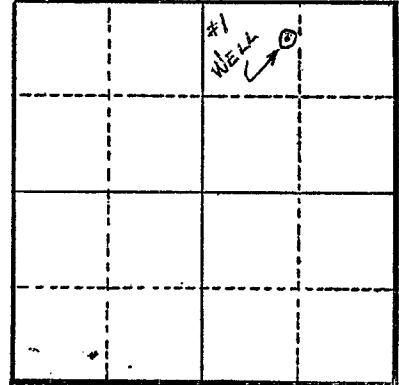

Section 23

Altitude at well

TYPE OF WELL: Drilled Date Constructed 1951

Depth drilled 179' Depth cased 126'

CASING RECORD:

8"

FINISH:

AQUIFERS:

WATER LEVEL:

50'

PUMPING EQUIPMENT: Type Pacific Submersible H.P. 5
Capacity 220 G.P.M.

WELL TESTS:

Drawdown 30 ft. after 145 hours G.P.M.

Drawdown ft. after hours G.P.M.

USE OF WATER Irrigation Temp. °F. 19

SOURCE OF INFORMATION GR Record

DRILLER or DIGGER A. M. Janssen

ADDITIONAL DATA:

Log Water Level Measurements Chemical Analysis Aquifer Test

REMARKS:

Log: Clay & sand 0 to 60 ft.
Sand, blue & yellow clay & black sand 60 to 108 ft.
Black sand & blue sand & clay 108 to 160 ft.
Sand & clay, dark green 160 to 179 ft.

Irrigation of 3 acres.