

STATE ENGINEER  
Salem, Oregon

WASH  
Well Record  
010144

STATE WELL NO. 1/2W-23K  
COUNTY WASHINGTON  
APPLICATION NO. GR-2540

OWNER: J. Richard Smurthwaite, Jr.


MAILING ADDRESS: Rt. 2, Box 512

LOCATION OF WELL: Owner's No.

CITY AND STATE: Beaverton, Oregon

NW 1/4 SE 1/4 Sec. 23 T. 1 S., R. 2 W., W.M.

Bearing and distance from section or subdivision corner 1500' N. & 1400' W.

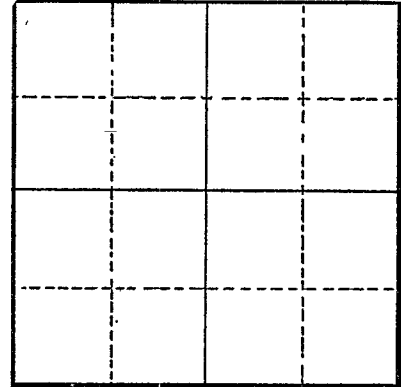

Section

Altitude at well

TYPE OF WELL: Drilled Date Constructed 1938

Depth drilled 138 Depth cased ?

CASING RECORD:

6-inch

FINISH:

AQUIFERS:

WATER LEVEL:

32-feet

PUMPING EQUIPMENT: Type Myers Piston H.P. 2  
Capacity 18 G.P.M.

WELL TESTS:

Drawdown ft. after hours G.P.M.  
Drawdown ft. after hours G.P.M.

USE OF WATER Irrigation Temp. °F. 19

SOURCE OF INFORMATION GR-2400

DRILLER or DIGGER

ADDITIONAL DATA:

Log Water Level Measurements Chemical Analysis Aquifer Test

REMARKS: