

NOTICE TO WATER WELL CONTRACTOR

The original and first copy of this report are to be filed with the

WATER WELL REPORT

STATE ENGINEER, SALEM, OREGON 97310 within 30 days from the date of well completion.

JAN 8 1965 STATE OF OREGON JAN 12 1965 (Please type or print)

State Well No. 1/2w-23R State Permit No. G

(1) OWNER:

Name Aloha-Huber Water District Address 17880 S. W. Blanton Aloha, Oregon

(2) LOCATION OF WELL:

County Wash Driller's well number 1/4 Section 23 T. 1S R. 2W W.M. Bearing and distance from section or subdivision corner

(3) TYPE OF WORK (check):

New Well [x] Deepening [] Reconditioning [] Abandon [] Abandonment, describe material and procedure in Item 12.

(4) PROPOSED USE (check):

Domestic [] Industrial [] Municipal [x] Irrigation [] Test Well [] Other []

(5) TYPE OF WELL:

Rotary [] Driven [] Cable [x] Jetted [] Dug [] Bored []

(6) CASING INSTALLED:

16" Diam. from 0 ft. to 402 ft. Gage .330 12" Diam. from 616 1/4" ft. to 728 ft. Gage .250

(7) PERFORATIONS:

Perforated? [x] Yes [] No Type of perforator used Torch Size of perforations 3/16 in. by 12 in. 240 perforations from 630 ft. to 710 ft.

(8) SCREENS:

Well screen installed? [] Yes [x] No Manufacturer's Name Type Model No. Slot size Set from ft. to Diam. Slot size Set from ft. to

(9) CONSTRUCTION:

Well seal—Material used in seal Cement Depth of seal 403 ft. Was a packer used? No Diameter of well bore to bottom of seal 24" in. Were any loose strata cemented off? [] Yes [x] No Depth Was a drive shoe used? [] Yes [x] No Was well gravel packed? [] Yes [x] No Size of gravel: Gravel placed from ft. to ft. Did any strata contain unusuable water? [] Yes [x] No Type of water? depth of strata Method of sealing strata off

(10) WATER LEVELS:

Static level 200 ft. below land surface Date 11-17-64 Artesian pressure lbs. per square inch Date

(11) WELL TESTS:

Drawdown is amount water level is lowered below static level Was a pump test made? [x] Yes [] No If yes, by whom? Yield: 500 gal./min. with 38 ft. drawdown after 24 hrs. 900 " 58 58 " 24 " 1250 " 78 " 12 " Bailer test gal./min. with ft. drawdown after hrs. Artesian flow g.p.m. Date Temperature of water 58 Was a chemical analysis made? [x] Yes [] No

(12) WELL LOG:

Diameter of well below casing 16 Depth drilled 874 ft. Depth of completed well 874 ft. Formation: Describe by color, character, size of material and structure, and show thickness of aquifers and the kind and nature of the material in each stratum penetrated, with at least one entry for each change of formation.

Table with columns MATERIAL, FROM, TO. Content: See attached sheets

Work started 19 Completed 11-17 1964 Date well drilling machine moved off of well 11-20 1964

(13) PUMP:

Manufacturer's Name Type: H.P.

Water Well Contractor's Certification:

This well was drilled under my jurisdiction and this report is true to the best of my knowledge and belief.

NAME A. M. Janssen Drilling Co. (Person, firm or corporation) Address 21075 S. W. Tualatin Valley Hwy., Aloha, Oregon

Drilling Machine Operator's License No. 164 [Signed] Edward M. Janssen (Water Well Contractor) Contractor's License No. 79 Date 1-6-65 19

WASH 10148

Water Well Report

1/2w-23 *dd*

Owner: Aloha-Huber Water District
17880 S. W. Blanton
Aloha, Oregon

RECEIVED
JAN 12 1965
STATE ENGINEER
SALEM, OREGON

(12) WELL LOG:

Material	From	To	Well # 2
Clay	0	5	feet
Clay & rock - broken brown	5	24	
Clay & rock - broken red	24	27	
Rock & some clay - gray	27	49	
Rock, solid - gray	49	52	
Soft brown rock	52	69	
Brown rock - a little harder	69	89	
Light brown rock - hard	89	101	
Hard gray rock	104	107	
Broken gray rock	107	115	
Soft brown rock	115	122	
Hard gray rock	122	150	
Soft brown rock	150	152	
Hard brown rock	152	158	
Soft brown rock	158	162	
Hard brown rock	162	167	
Very soft brown rock	167	181	
Hard brown rock	181	211	
Soft brown rock	211	216	
Harder brown rock	216	255	
Hard gray rock	255	292	
Fairly soft gray rock	292	331	
Hard gray rock	331	394	
Fairly soft rock - gray - broken	394	403	
Hard gray rock	403	410	
Soft brown rock	410	420	
Hard gray rock	420	450	
Broken gray rock	450	467	
Hard gray rock	467	470	
Broken brown rock	470	485	
Very hard gray rock	485	523	
Broken rock with gray seams	523	528	
Gray rock	528	560	
Broken rock	560	576	
Gray rock	576	597	
Gray & white clay	597	601	
Gray rock	601	647	
Crevice - water bearing	647	651	
Hard gray rock	651	656	
Wormy rock - water bearing	656	667	
Broken rock - water bearing	667	682	
Brown & gray rock	682	698	

Cont. next page

Water Well Report
 Well Log - Page 2
 Aloha-Huber Water District

RECEIVED
 JAN 12 1965

RECEIVED
 JAN 8 1965
 STATE ENGINEER
 HALEN, OREGON

Material	From	To
Black Broken Rock - water	698	706
" " "	706	715
Black solid hard rock	715	720
Broken black rock	720	730
Gray hard rock	730	738
Softer rock	738	747
Hard gray rock	747	750
Softer gray rock	750	767
Hard gray rock	767	770
Clay & gray rock mixed	770	772
Gray soft rock	772	780
Medium hard gray rock	780	788
Very hard gray rock	788	802
Hard black rock	802	808
Broken black rock	808	817
Hard black rock, making water	817	820
Broken black rock, making water	820	833
Very hard black rock - crevices	833	852
Black rock - crevices - very heavy	852	855
Black rock	855	858
Shale, very hard	858	874
Total depth		874

RECEIVED
DEC 18 1964


1/2W-238
06

STAT. ENGINEER

SALESMAN, ENGINEER

Note:
16" Well drilled and tested by
A.M. Jahnson Drilling Co.
Well tested 11/13/64 - 8 hrs.
1/16, 17/64 - 24 hrs.
Total depth - 874 ft
Cased to - 402 ft

PUMPING LEVEL - FEET
340
320
300
280
260
240
220
200
190

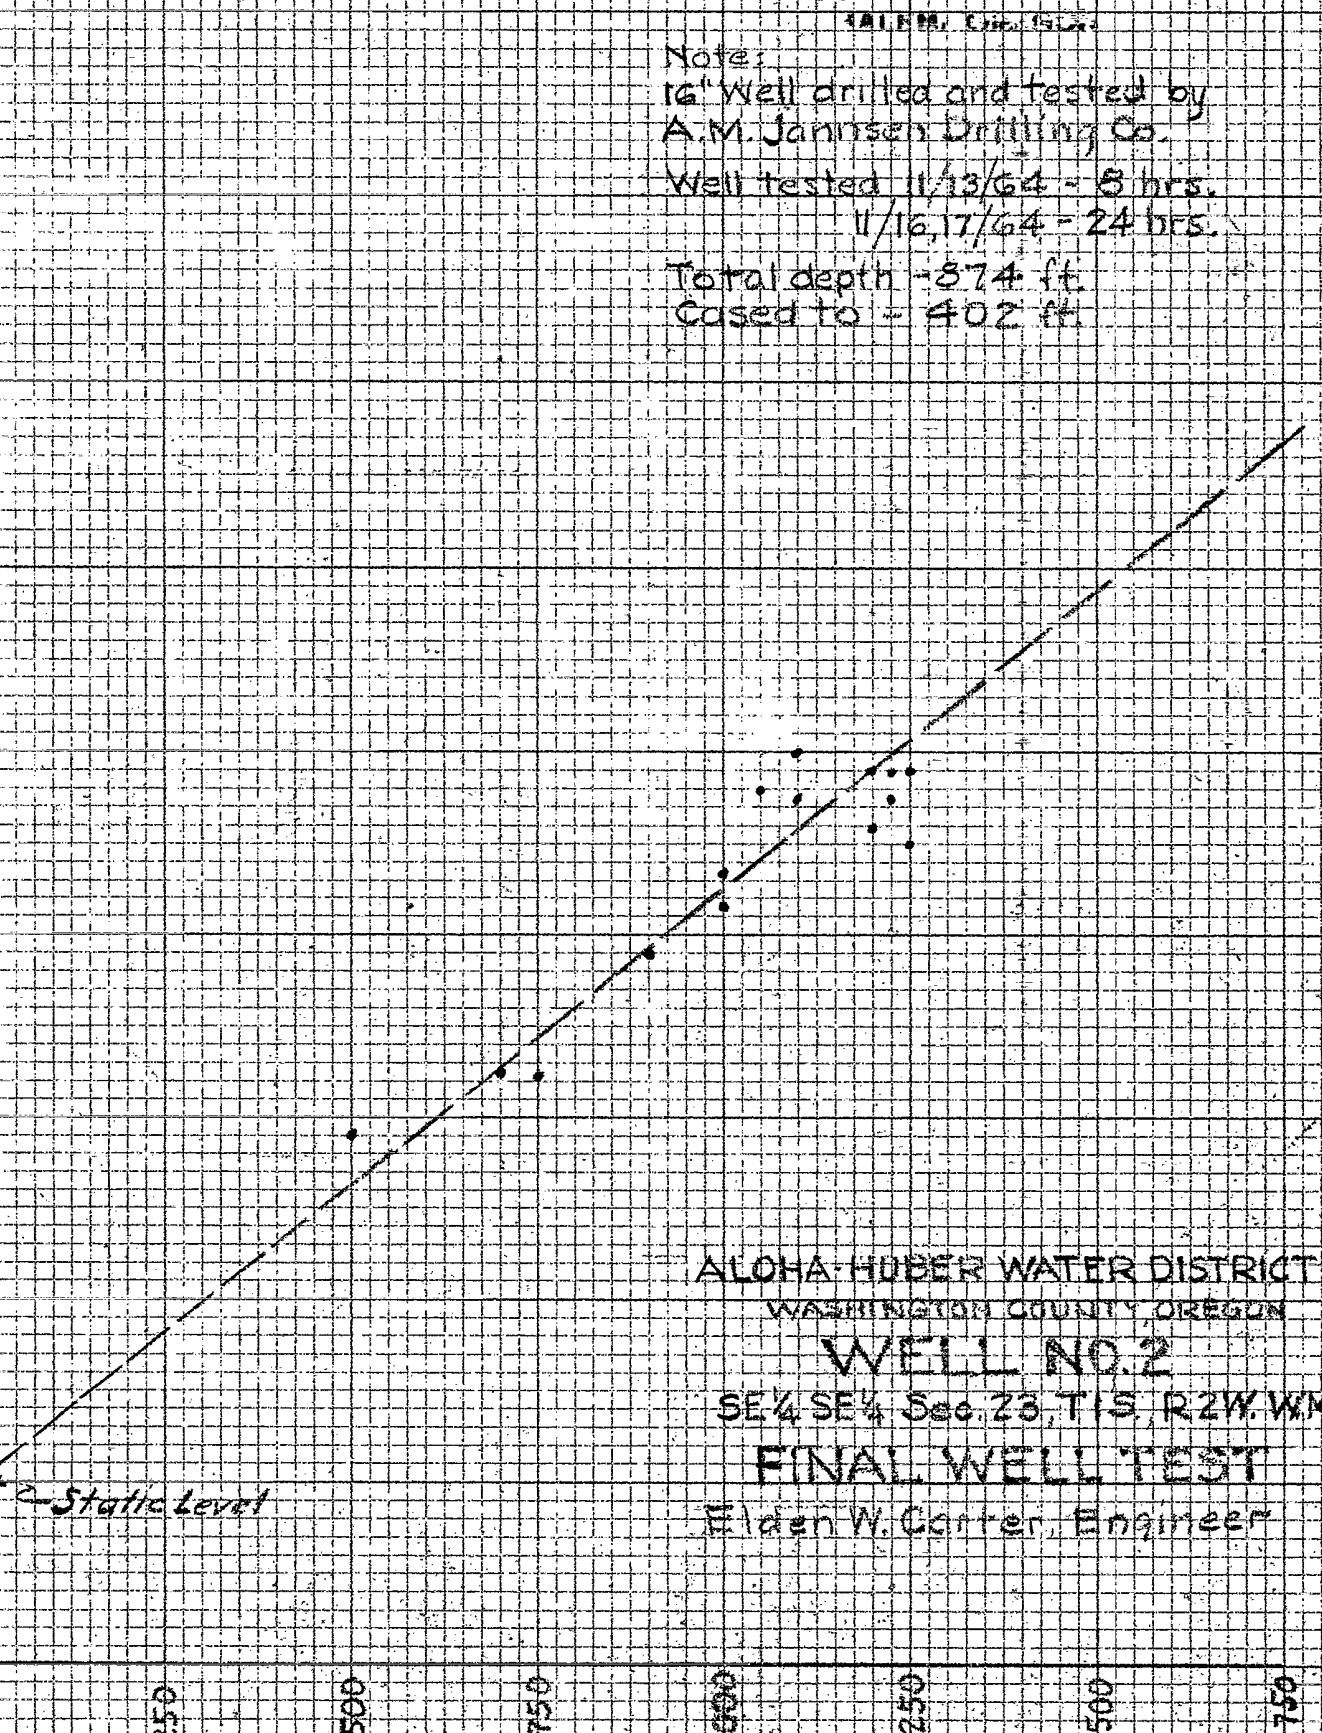

ALOHA-HUBER WATER DISTRICT
WASHINGTON COUNTY, OREGON
WELL NO. 2
SE 1/4 SE 1/4 Sec. 23, T15, R2W, WM.
FINAL WELL TEST
Elden W. Carter, Engineer

GALLONS PER MINUTE



Oregon Water Resources Department
725 Summer Street NE, Suite A
Salem Oregon 97301
(503) 986-0900
www.wrd.state.or.us

Application for
Well ID Number

RECEIVED

JUL 16 2009

WATER RESOURCES DEPT
SALEM, OREGON

Do not complete if the well already has a Well I.D Number.

I. OWNER INFORMATION

Current Owner Name (please print): Tualatin Valley Water District; Attn: Joel A. Cary
Mailing Address: 1850 SW 170th Avenue
City: Beaverton State: OR Zip: 97006
Mailing Address (to send Well I.D.): Same as above
City: State: Zip:

II. WELL INFORMATION (Do not complete this section if the well report is attached.)

Township: (North/South) Range: (East/West) Section:
Tax Lot: County: 1/4 1/4
Street Address of Well: City:
Owner at time the well was constructed, (if known):
If the property had a different street address in the past:

III. GENERAL WELL INFORMATION (Do not complete this section if the well report is attached)

Use of Well (domestic, irrigation, commercial, industrial, monitoring):
Date Well Constructed: Total Well Depth: Casing Diameter:
Other Information:

SUBMITTED BY (please print): Joel A. Cary (missing tag; requesting new number/tag) L- 68043 lost!
PHONE: D; 503.848.3019 FAX: 503.356.3119

* WRD staff notes: Well ID # 68043 assigned at alteration (WASH 60890)
LOST! This is a request for replacement well ID.

Send application to Oregon Water Resources Department; 725 Summer St NE, Suite A; Salem, Oregon 97301-1266; fax (503) 986-0902. Applications are processed and Well I.D. Numbers are mailed every Wednesday.

WASH 10148 (original)

* Replacement *

For Official Use Only by the Oregon Water Resources Department:

Received Date:

7-16-09

Well Log Number:

WASH 60890 (alt)

Well Identification #:

L-100484