

STATE ENGINEER
Salem, Oregon

WASH Well Record
010189

STATE WELL NO. 1/2W-24A
COUNTY WASHINGTON
APPLICATION NO. GR-2806

OWNER: E. L. Hannabass


MAILING ADDRESS: 18905 S.W. Farmington Rd.

LOCATION OF WELL: Owner's No.

CITY AND STATE: Beaverton, Oregon

NE 1/4 NE 1/4 Sec. 24 T. 1 N. S, R. 2 E. W., W.M.

Bearing and distance from section or subdivision corner 1580' SW

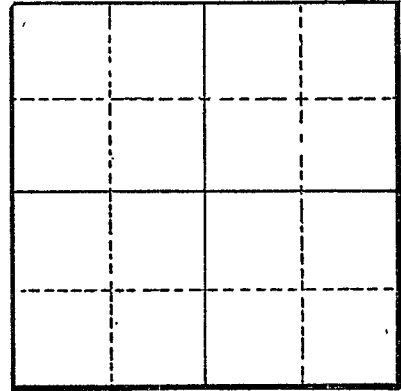

Section

Altitude at well

TYPE OF WELL: drilled Date Constructed 1952

Depth drilled 255 Depth cased 255

CASING RECORD:

- 6-inch
- 4-inch
- 4-inch

FINISH:

AQUIFERS:

Clay and rock

WATER LEVEL:

16-feet

PUMPING EQUIPMENT: Type Berkeley jet H.P. 1 1/2
Capacity 17 G.P.M.

WELL TESTS:

Drawdown ft. after hours Pumping 17 G.P.M.
Drawdown ft. after hours G.P.M.

USE OF WATER irrigation Temp. °F., 19

SOURCE OF INFORMATION GR-2648

DRILLER or DIGGER

ADDITIONAL DATA:

Log X Water Level Measurements Chemical Analysis Aquifer Test

REMARKS:

Clay 152' 6" 152' 6"
Very hard rock 12' 6" 165'
Intermittent hard to soft layers of rock 90' 255'