

STATE ENGINEER  
Salem, Oregon

WASH  
010213

# Well Record


STATE WELL NO. 1/2W-24Q  
COUNTY Washington  
APPLICATION NO. GR-4028

OWNER: Lyle R. Miller & Mrs. James Miller MAILING ADDRESS: 7630 SW 195th Ave.

LOCATION OF WELL: Owner's No. CITY AND STATE: Beaverton, Oregon

SW 1/4 SE 1/4 Sec. 24 T. 1 S., R. 2 W., W.M.

Bearing and distance from section or subdivision corner 800' N. & 150' E. from S 1/4 Cor. Sec. 24

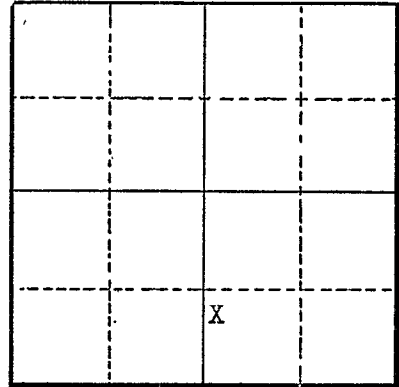

Section 24

Altitude at well

TYPE OF WELL: Drilled Date Constructed 5/4/51

Depth drilled 241 ft. Depth cased 241 ft.

### CASING RECORD:

- 6' Standard Eastern with 1/2 collar cased to 21 ft.
- 6" cemented & drilled from 104 to 127 feet
- 6" thru solid rock from 127 to 241 feet

### FINISH:

### AQUIFERS:

### WATER LEVEL:

230 feet below surface

PUMPING EQUIPMENT: Type Myers pump H.P. 3  
Capacity 8 or 12 G.P.M.

### WELL TESTS:

Drawdown ..... ft. after ..... hours ..... G.P.M.  
 Drawdown ..... ft. after ..... hours ..... G.P.M.

USE OF WATER Irrigation Temp. °F. 19

SOURCE OF INFORMATION Well Registration Statement Cert. # GR-3627

DRILLER or DIGGER A. M. Janssen Well Drillers

### ADDITIONAL DATA:

Log ..... Water Level Measurements ..... Chemical Analysis ..... Aquifer Test .....

### REMARKS: