

STATE ENGINEER
Salem, Oregon

WASH
010215

Well Record

STATE WELL NO. 1S/2W-24R
COUNTY WASHINGTON
~~APPLICATION NO. GR-2393~~

OWNER: Fred and Georgina Vedder


MAILING ADDRESS: 19800 S.W. Marlin Drive

LOCATION OF WELL: Owner's No.

CITY AND STATE: Beaverton, Oregon

SE 1/4 SE 1/4 Sec. 24 T. 1 S, R. 2 W., W.M.

Bearing and distance from section or subdivision corner 700' 18° N. of W.

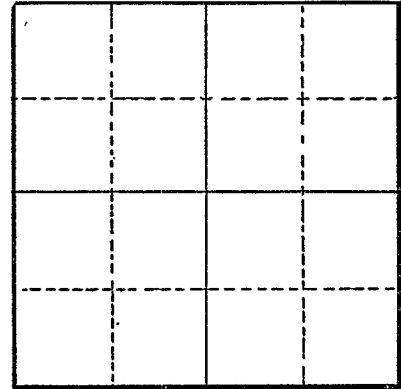

Section

Altitude at well

TYPE OF WELL: Drilled Date Constructed 1955

Depth drilled 108 Depth cased 108

CASING RECORD:

6-inch

FINISH:

AQUIFERS:

Clay and Rock

WATER LEVEL:

PUMPING EQUIPMENT: Type Horort pump jet H.P. 1
Capacity 9 G.P.M.

WELL TESTS:

Drawdown 0 ft. after hours Pumping 7 G.P.M.
Drawdown ft. after hours G.P.M.

USE OF WATER Irrigation Temp. °F. 19

SOURCE OF INFORMATION GR-2274
DRILLER or DIGGER Paul Ross Mi 4-5342, 2040 S.W. 192 Roe, Beaverton, Oregon

ADDITIONAL DATA:

Log ^X Water Level Measurements Chemical Analysis Aquifer Test

REMARKS:

Clay 18' 18'
Rock 90' 108'