

STATE ENGINEER
Salem, Oregon

WASH

Well Record

STATE WELL NO. 1/2W-26A
COUNTY Washington
APPLICATION NO. GR-3990

010279

OWNER: The United States National Bank
of Portland, Trustee


MAILING ADDRESS: Trust Dept., P.O. Box 4410

LOCATION OF WELL: Owner's No.

CITY AND STATE: Portland 8, Oregon

NE¹/₄ NE¹/₄ Sec. 26 T. 1 S., R. 2 W., W.M.

Bearing and distance from section or subdivision
corner 950' W. & 720' S. of Sec. Cor. of Sec. 23,
24, 25 & 26

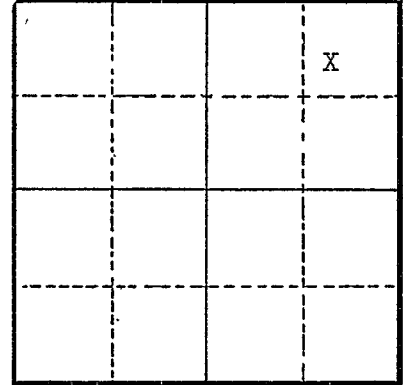

Section 26

Altitude at well

TYPE OF WELL: Drilled Date Constructed

Depth drilled 400 ft. Depth cased

CASING RECORD:

FINISH:

AQUIFERS:

WATER LEVEL:

PUMPING EQUIPMENT: Type "Standard" turbine pump H.P. 7 1/2
Capacity 20-25 G.P.M.

WELL TESTS:

Drawdown ft. after hours G.P.M.
Drawdown ft. after hours G.P.M.

USE OF WATER Irrigation Temp. °F. 19

SOURCE OF INFORMATION Well Registration Statement Cert. # GR-3599

DRILLER or DIGGER Jansen Drilling Company

ADDITIONAL DATA:

Log Water Level Measurements Chemical Analysis Aquifer Test

REMARKS: