

STATE ENGINEER
Salem, Oregon

WASH

Well Record

STATE WELL NO. 1/2W-290
COUNTY Washington
APPLICATION NO. GR-1316

010409

GR- 1272

OWNER: Putnam Bros.


MAILING ADDRESS: Rt. 2, Box 232

LOCATION OF WELL: Owner's No.

CITY AND STATE: Hillsboro, Oregon

SW 1/4 SE 1/4 Sec. 29 T. 1 S., R. 2 W., W.M.

Bearing and distance from section or subdivision corner N.23°E. 675' from S 1/4 cor. of Sec. 29

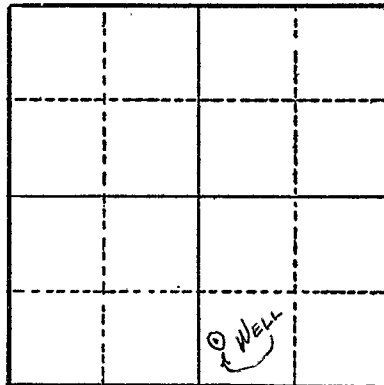

Section 29

Altitude at well 155 ft.

TYPE OF WELL: Drilled Date Constructed 1945

Depth drilled 505 ft. Depth cased 445 ft.

CASING RECORD:

6 inch

FINISH:

AQUIFERS:

WATER LEVEL:

Flowing with shut in pressure of 8 PSI. in 1945

PUMPING EQUIPMENT: Type Rotary pump H.P. 2
Capacity 35 G.P.M.

WELL TESTS:

Drawdown 0 ft. after hours 135 G.P.M.
Drawdown ft. after hours G.P.M.

USE OF WATER Irrigation Temp. °F., 19

SOURCE OF INFORMATION G. R. Record

DRILLER or DIGGER Art Gaunt

ADDITIONAL DATA:

Log Water Level Measurements Chemical Analysis Aquifer Test

REMARKS:

Log: Quicksand 0 to 90 ft.
Clay 90 to 445 ft.
Rock 445 to 505 ft.

Irrigation of 7.5 acres.

