

STATE ENGINEER
Salem, Oregon

WASH

Well Record

STATE WELL NO. 15/2W 22PK1)
COUNTY Washington
APPLICATION NO.

010410

OWNER: W. Schallberger


MAILING ADDRESS: Rt. 4, Box 192

LOCATION OF WELL: Owner's No.

CITY AND STATE: Hillsboro, Oregon

SE 1/4 SW 1/4 Sec. 29 T. 1 S., R. 2 W., W.M.

Bearing and distance from section or subdivision corner
S 30° 15' E 1750' from NW cor.
Felix Landess DLC #52.

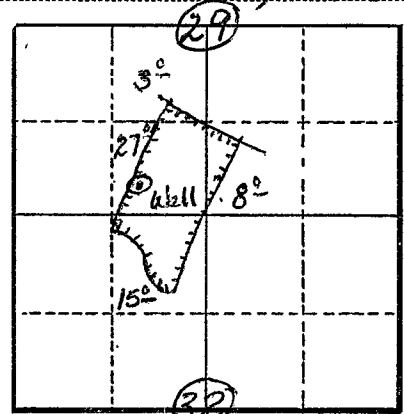

Section

Altitude at well 165 ft.

TYPE OF WELL: drilled Date Constructed

Depth drilled 750 ft. Depth cased

CASING RECORD: 6 inch - 0 to 200 ft.
11 inch - 200 to 700 ft.
From 700ft. - open lake

FINISH:

AQUIFERS: Basalt from 450 to 750 ft.

WATER LEVEL: F

PUMPING EQUIPMENT: Type Jet - GOULDS CENT. H.P. 20
Capacity 450 G.P.M.

WELL TESTS:
Drawdown ft. after hours G.P.M.
Drawdown ft. after hours G.P.M.

USE OF WATER domestic - Irrig. Temp. °F., 19

SOURCE OF INFORMATION U.S.G.S. - RELATED REG. STATEMENT

DRILLER or DIGGER

ADDITIONAL DATA:
Log Water Level Measurements Chemical Analysis Aquifer Test

REMARKS: Reportedly flows 120 g.p.m.; test pumped 600 g.p.m. with centrifugal pump without breaking suction.

IRRIGATION OF 54⁰ ACRES