

STATE ENGINEER
Salem, Oregon

WASH

Well Record

STATE WELL NO. 1/2W-30
COUNTY WASHINGTON
APPLICATION NO. GR-2828

010425


OWNER: Sebe S. Dalley & Mabel Dalley
husband and wife

MAILING ADDRESS: Rt. 4, Box 195

LOCATION OF WELL: Owner's No.

CITY AND STATE: Hillsboro, Oregon

SE of 1/4 30 NW of 31 1/4 Sec. 30 T. 12 N. S. R. 2 E. W., W.M.

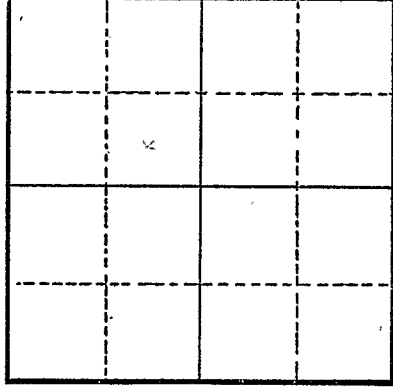

Section 30

Bearing and distance from section or subdivision corner 550' N. 21° 0' W.

Altitude at well

TYPE OF WELL: drilled Date Constructed 1944

Depth drilled 380 Depth cased 380

CASING RECORD:

6-inch

FINISH:

AQUIFERS:

WATER LEVEL:
60-feet

PUMPING EQUIPMENT: Type Mors. Submersible H.P. 1
Capacity 15 G.P.M.

WELL TESTS:
Drawdown 60 ft. after hours Pumping 15 G.P.M.
Drawdown ft. after hours G.P.M.

USE OF WATER irrigation Temp. °F., 19

SOURCE OF INFORMATION GR-2667

DRILLER or DIGGER Art. Gaunt 19300 S.W. Kinnaman Rd., Aloha, Oregon

ADDITIONAL DATA:

Log Water Level Measurements Chemical Analysis Aquifer Test

REMARKS: