

STATE ENGINEER  
Salem, Oregon

WASH

Well Record

STATE WELL NO. 134-7150<sup>bd</sup>  
COUNTY Wash.  
APPLICATION NO. GR-9707

010465

OWNER: Louis R Malensky


MAILING ADDRESS: Rt #1

LOCATION OF WELL: Owner's No. \_\_\_\_\_

CITY AND STATE: Hillsboro, Ore

NE 1/4 NW 1/4 Sec. 31 T. 1 S., R. 2 W., W.M.

Bearing and distance from section or subdivision  
corner N. 55° 41' W. 1954.38 FT.  
from S.W. cor. of Charles  
Lewis DTC # 51

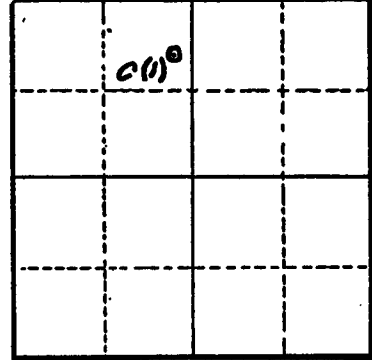

Section 31

Altitude at well 175

TYPE OF WELL: drilled Date Constructed ?

Depth drilled 700 Depth cased 700

CASING RECORD:

6 inch

FINISH:

AQUIFERS:

WATER LEVEL:

?

PUMPING EQUIPMENT: Type Centrifugal HP. 15  
Capacity \_\_\_\_\_ G.P.M.

WELL TESTS:

Drawdown \_\_\_\_\_ ft. after \_\_\_\_\_ hours \_\_\_\_\_ G.P.M.

Drawdown \_\_\_\_\_ ft. after \_\_\_\_\_ hours \_\_\_\_\_ G.P.M.

USE OF WATER irrigation - 139.6 ac, Temp. \_\_\_\_\_ °F., 19 \_\_\_\_\_

SOURCE OF INFORMATION GR-477

DRILLER or DIGGER \_\_\_\_\_

ADDITIONAL DATA:

Log No Water Level Measurements \_\_\_\_\_ Chemical Analysis \_\_\_\_\_ Aquifer Test \_\_\_\_\_

REMARKS:

MAP #4

3-29-49

"A"

G. E. ASBAHR  
5933 N.E. 25th, City

6" well, 715' Deep, Static 2½', 290 g.p.m. @ 20'  
Casing used 266' of 6"

Drilled on Farmington Road 2 miles West of Twin Oaks

(LOG OVER)



AUG 11 1994

0' to	20'	Brown Clay
20'	22'	Creek Sand
	37'	Blue Mud
	43'	Blue fine sand
	77'	Blue Mud
	159'	Brown Clay
	168'	Grey Clay
	194'	Blue Sticky Clay
	200'	Clay & Gravel
	204'	Gravel
	225'	Red Clay
	261'	Brown Clay
	269'	Decomposed Rock
	270'	Rock
	285'	Cemented Gravel
	428'	Rock
	430'	Sand Rock
	463'	Rock
	469'	Decomposed Rock
	715'	Rock

This is the original  
driller's report for the  
well on claim GR-477 (WASH 10465)  
as documented in water  
right file G-13550.  
K. Wozniak Groundwater

*File  
#G-13550*