

STATE ENGINEER  
Salem, Oregon

WASH

# Well Record

STATE WELL NO. 1/3W-2P  
COUNTY Washington  
APPLICATION NO. GR-1395

010573

GR-1351

OWNER: Keith M. Clark

MAILING  
ADDRESS:

LOCATION OF WELL: Owner's No.


CITY AND  
STATE:

Hillsboro, Oregon

SE 1/4 SW 1/4 Sec. 2 T. 1 N. S, R. 3 W., W.M.

Bearing and distance from section or subdivision

corner N. 24° E. 552' from SW cor. of Noah Jobe DLG #50, said cor. being N 89° 13' E. from SW cor. of Section 2. 2246.2'

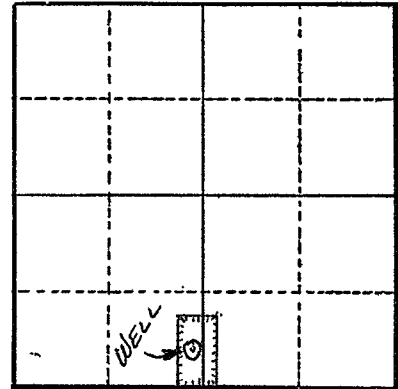

Altitude at well 190 ft.

TYPE OF WELL: Drilled Date Constructed 1953

Depth drilled 48 ft. Depth cased 48 ft.

Section 2

### CASING RECORD:

6 inch

### FINISH:

Perforated from top to bottom with a double row of 1/8 x 12 in. torch cuts.

### AQUIFERS:

### WATER LEVEL:

10 ft. ~~10 ft.~~

PUMPING EQUIPMENT: Type Berkeley Jet

H.P. 2

Capacity 30 G.P.M.

### WELL TESTS:

Drawdown 20 ft. after 30 hours G.P.M.

Drawdown ft. after hours G.P.M.

USE OF WATER Irrigation Temp. °F. 19

SOURCE OF INFORMATION G. R. Record

DRILLER or DIGGER

### ADDITIONAL DATA:

Log Water Level Measurements Chemical Analysis Aquifer Test

### REMARKS:

Log: Top soil 0 to 2.5 ft.  
Brown clay 2.5 to 7 ft.  
Layered formation of brown sand & clay 7 to 20 ft.  
Layered formation of blue clay & sand 20 to 48 ft.

Irrigation of 15 acres.