

STATE ENGINEER
Salem, Oregon

WASH

Well Record

STATE WELL NO. 1/3W-3 A
COUNTY Washington
APPLICATION NO. GR-3290

010580

OWNER: Orville W. Brindle

MAILING ADDRESS: Route 2, Box 90

LOCATION OF WELL: Owner's No.

CITY AND STATE: Cornelius, Oregon

NE $\frac{1}{4}$ NE $\frac{1}{4}$ Sec. 3 T. 1 S. R. 3 W., W.M.


Bearing and distance from section or subdivision

corner 680' W. and 200' S.

Altitude at well

TYPE OF WELL: Bored Date Constructed 1949

Depth drilled 20' Depth cased 20'

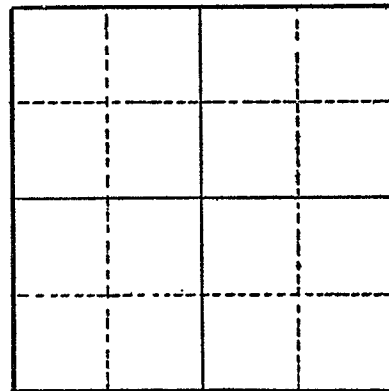

Section

CASING RECORD:

6"

FINISH:

AQUIFERS:

clay, sand, blue sand

WATER LEVEL:

20'

PUMPING EQUIPMENT: Type Pacific Pump H.P. 1 $\frac{1}{2}$
Capacity 21 G.P.M.

WELL TESTS:

Drawdown ft. after hours pumping 21 G.P.M.
Drawdown ft. after hours G.P.M.

USE OF WATER Irrigation Temp. °F. 19
SOURCE OF INFORMATION GR-3076

DRILLER or DIGGER

ADDITIONAL DATA:

Log ^x Water Level Measurements Chemical Analysis Aquifer Test

REMARKS:

6' clay - sand - blue sand