

STATE ENGINEER  
Salem, Oregon

WASH

Well Record

STATE WELL NO. 1/3W-3G  
COUNTY Washington  
APPLICATION NO. GR-4016

010584

OWNER: Everett Grabeel

MAILING

ADDRESS: Route 2, Box 97

LOCATION OF WELL: Owner's No.


CITY AND

STATE: Cornelius, Oregon

SW 1/4 NE 1/4 Sec. 3 T. 1 S., R. 3 W., W.M.

Bearing and distance from section or subdivision

corner S. 14° E. 1775 ft. from 1/4 Cor. on N. line of  
Sec. 3

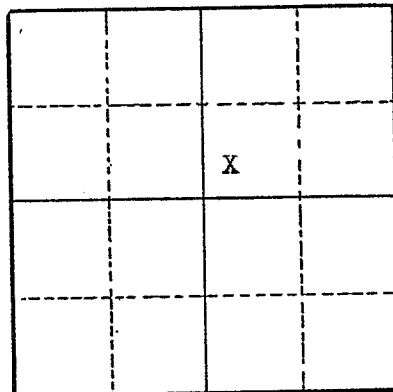

Section 3

Altitude at well

TYPE OF WELL: Drilled Date Constructed 1950

Depth drilled 53 ft. Depth cased 53 ft.

CASING RECORD:

6 inch casing set to 53 feet

FINISH:

Perforated

AQUIFERS:

WATER LEVEL:

8 feet below surface

PUMPING EQUIPMENT: Type 3 stage jet pump

H.P. 3

Capacity 36 G.P.M.

WELL TESTS:

Drawdown about 20 ft. after 36 hours G.P.M.

Drawdown ft. after hours G.P.M.

USE OF WATER Irrigation Temp. °F., 19

SOURCE OF INFORMATION Well Registration Statement Cert. # GR-3619

DRILLER or DIGGER

ADDITIONAL DATA:

Log Water Level Measurements Chemical Analysis Aquifer Test

REMARKS: