

STATE ENGINEER
Salem, Oregon

WASH Well Record

STATE WELL NO. 1/3W-4A
COUNTY Washington
APPLICATION NO. GR-1747

GR- 1694


OWNER: Lynn Brooks 010598

MAILING ADDRESS: 1810 Pacific Ave.

LOCATION OF WELL: Owner's No.

CITY AND STATE: Forest Grove, Oregon

NE 1/4 NE 1/4 Sec. 4 T. 1 S, R. 3 W, W.M.

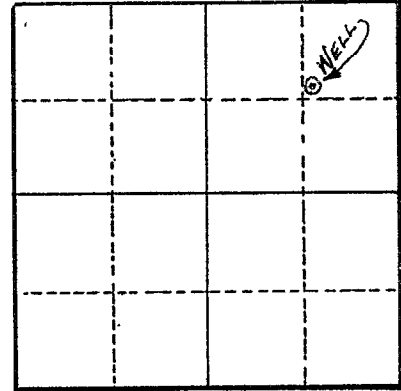

Bearing and distance from section or subdivision corner S.48°W. 1700' from NE Cor. Sec. 4

Section 4

Altitude at well

TYPE OF WELL: Drilled Date Constructed 1942

Depth drilled 60' Depth cased 60'

CASING RECORD:

6"

FINISH:

AQUIFERS:

WATER LEVEL:

10'

PUMPING EQUIPMENT: Type Myers jet H.P. 1
Capacity 20 G.P.M.

WELL TESTS:

Drawdown 10 ft. after 15 hours G.P.M.
Drawdown ft. after hours G.P.M.

USE OF WATER Irrigation Temp. °F., 19

SOURCE OF INFORMATION GR Record

DRILLER or DIGGER Baseline Drilling Co.

ADDITIONAL DATA:

Log N.A. Water Level Measurements Chemical Analysis Aquifer Test

REMARKS:

Irrigation of 1.5 acres.