

STATE ENGINEER
Salem, Oregon

WASH Well Record

STATE WELL NO. 1/3W-4D
COUNTY WASHINGTON
APPLICATION NO. GR-2312

010599

OWNER: Elvin T. and Clara V. Finegan


MAILING ADDRESS: Rt. 2, Box 54

LOCATION OF WELL: Owner's No.

CITY AND STATE: Cornelius, Oregon

NW 1/4 NW 1/4 Sec. 4 T. 1 N. S., R. 3 E. W., W.M.

Bearing and distance from section or subdivision corner S. 60° 0' E.

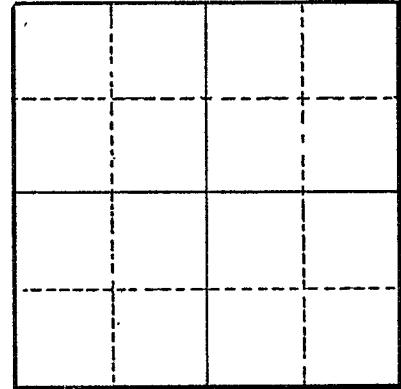

Section

Altitude at well

TYPE OF WELL: Drilled Date Constructed 1949

Depth drilled 92 Depth cased 55

CASING RECORD:

6-inch

FINISH:

AQUIFERS:

WATER LEVEL:

8 to 10-feet

PUMPING EQUIPMENT: Type Meyers Ejecto E-107 Jet Pump H.P. 1 1/2
Capacity 50 G.P.M.

WELL TESTS:

Drawdown 30 ft. after hours Pumping 42 G.P.M.
Drawdown ft. after hours G.P.M.

USE OF WATER Irrigation Temp. °F., 19

SOURCE OF INFORMATION GR-2203
DRILLER or DIGGER Carl Millet, Hillsboro, Oregon

ADDITIONAL DATA:

Log Water Level Measurements Chemical Analysis Aquifer Test

REMARKS: