

STATE ENGINEER
Salem, Oregon

WASH

Well Record

STATE WELL NO. 1/3W-4E
COUNTY Washington
APPLICATION NO. GR-1416

010600

GR-1970

OWNER: Dale Stocking

MAILING
ADDRESS:


LOCATION OF WELL: Owner's No.

CITY AND
STATE:

Cornelius, Oregon

SW 1/4 NW 1/4 Sec. 4 T. 1 S, R. 3 W., W.M.

Bearing and distance from section or subdivision
corner 320' W. & 500' S. from NE cor. of the
SW 1/4 of NW 1/4 of Sec. 4.

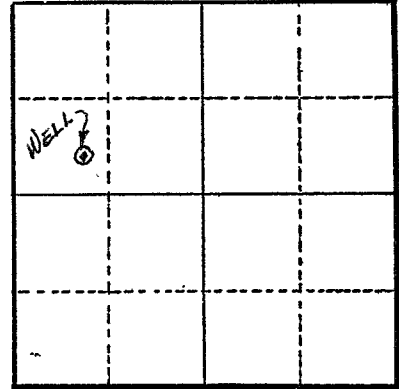

Section 4

Altitude at well

TYPE OF WELL: Drilled Date Constructed 1954

Depth drilled 183' Depth cased 183'

CASING RECORD:

8 inch

FINISH:

Torch perforations: 1/8" x 12" (4/ft.) from 100' to 180'

AQUIFERS:

WATER LEVEL:

19'

PUMPING EQUIPMENT: Type Jacuzzi turbine

H.P. 20

Capacity 300 G.P.M.

WELL TESTS:

Drawdown 81 ft. after 630 hours G.P.M.

Drawdown ft. after hours G.P.M.

USE OF WATER Irrigation Temp. °F. 19

SOURCE OF INFORMATION G. R. Record

DRILLER or DIGGER

ADDITIONAL DATA:

Log X Water Level Measurements Chemical Analysis Aquifer Test

REMARKS:

Irrigation of 62 acres.

