

STATE ENGINEER  
Salem, Oregon

WASH

# Well Record


STATE WELL NO. 1/3W-4L  
COUNTY Washington  
APPLICATION NO. GR-3587

**010602**

OWNER: Charles C. Tinegan MAILING ADDRESS: Route 2, Box 55  
CITY AND STATE: Cornelius, Oregon

LOCATION OF WELL: Owner's No. \_\_\_\_\_  
NE 1/4 SW 1/4 Sec. 4 T. 1 S., R. 3 W., W.M.

Bearing and distance from section or subdivision  
corner N. 36° 30' E. 3260' from SW corner Sec. 4

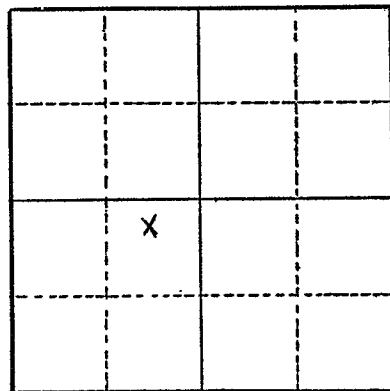

Section 4

Altitude at well \_\_\_\_\_

TYPE OF WELL: Drilled Date Constructed Aug., 1951

Depth drilled 80 ft. Depth cased 43 ft.

### CASING RECORD:

6 inch casing set to 43 feet

### FINISH:

### AQUIFERS:

sand

### WATER LEVEL:

10 feet below surface

PUMPING EQUIPMENT: Type Myers Jet electric H.P. 1 1/2  
Capacity 1800 G.P.M.

### WELL TESTS:

Drawdown 22 ft. after \_\_\_\_\_ hours 27 G.P.M.  
Drawdown \_\_\_\_\_ ft. after \_\_\_\_\_ hours \_\_\_\_\_ G.P.M.

USE OF WATER Irrigation Temp. \_\_\_\_\_ °F. \_\_\_\_\_, 19\_\_\_\_

SOURCE OF INFORMATION Well Registration Statement

DRILLER or DIGGER \_\_\_\_\_

### ADDITIONAL DATA:

Log  Water Level Measurements \_\_\_\_\_ Chemical Analysis \_\_\_\_\_ Aquifer Test \_\_\_\_\_

### REMARKS:

Log:	Thickness	Depth to Bottom
Br. sand & clay	20	20
Bl. clay & gray sand	23	43
Blue clay (hard)	3	46
Gray sand	30	76
Dark coarse sand	4	80