

STATE ENGINEER
Salem, Oregon

WASH Well Record

STATE WELL NO. 1/3W-4M
COUNTY WASHINGTON
APPLICATION NO. GR-2313

OWNER: Elvin T. and Clara V. Finegan


MAILING ADDRESS: Rt. 2, Box 54, Cornelius,

LOCATION OF WELL: Owner's No. _____

CITY AND STATE: Oregon

NW 1/4 SW 1/4 Sec. 4 T. 1 S., R. 3 E., W.M.

Bearing and distance from section or subdivision corner S. 84° 13' 70" W.

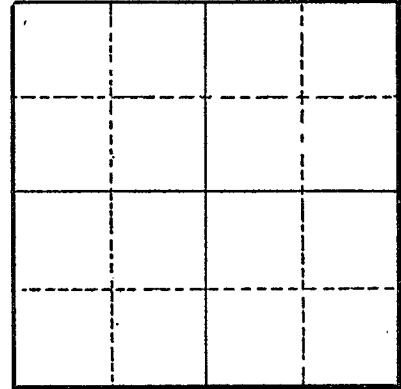

Section _____

Altitude at well _____

TYPE OF WELL: Drilled Date Constructed 1949

Depth drilled 65 Depth cased 50

CASING RECORD:

6-inch

FINISH:

AQUIFERS:

Topsoil, loam, clay and sand

WATER LEVEL:

8 to 10-feet

PUMPING EQUIPMENT: Type Jet Pump H.P. 1 1/2
Capacity 50 G.P.M.

WELL TESTS:

Drawdown 20 ft. after _____ hours Pumping 40 G.P.M.
Drawdown _____ ft. after _____ hours _____ G.P.M.

USE OF WATER Irrigation Temp. _____ °F. _____, 19____

SOURCE OF INFORMATION GR-2204
DRILLER or DIGGER Elvin Finegan, Rt. 2, Cornelius, Oregon

ADDITIONAL DATA:

Log Water Level Measurements _____ Chemical Analysis _____ Aquifer Test _____

REMARKS:

Topsoil - Willamette Loam 2' to 2'
Yellow Clay sub soil 25' to 27'
Grayish-blue (Sandy soil) 23' to 50'
Hard pan 3- to 53'
Gray-blue sand 12' to 65'