

STATE ENGINEER
Salem, Oregon

WASH

Well Record

STATE WELL NO. 1/3W - 5B
COUNTY WASHINGTON
APPLICATION NO. GR-2188

010606

OWNER: Frank J. Reichard


MAILING ADDRESS: Rt. 2, Box 32

LOCATION OF WELL: Owner's No.

CITY AND STATE: Cornelius, Oregon

NW 1/4 NE 1/4 Sec. 5 T. 1 N. S. R. 3 W., W.M.

Bearing and distance from section or subdivision corner S. 700' W. 1740'

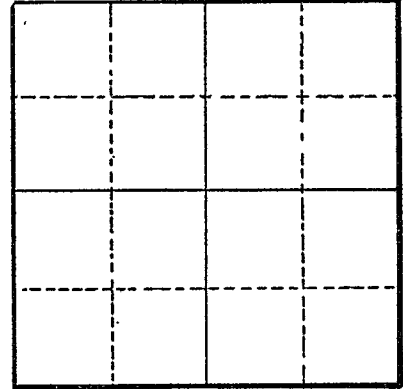

Section

Altitude at well

TYPE OF WELL: Drilled Date Constructed 1900

Depth drilled 40 Depth cased 35

CASING RECORD:

4-Inch

FINISH:

AQUIFERS:

WATER LEVEL:

18-Feet

PUMPING EQUIPMENT: Type Fairbanks Morse Jet H.P. 1
Capacity 25 G.P.M.

WELL TESTS:

Drawdown 18 ft. after Pumping 15 hours G.P.M.
Drawdown ft. after hours G.P.M.

USE OF WATER Irrigation Temp. °F. 19

SOURCE OF INFORMATION GR-2093

DRILLER or DIGGER

ADDITIONAL DATA:

Log Water Level Measurements Chemical Analysis Aquifer Test

REMARKS: