

STATE ENGINEER
Salem, Oregon

WASH

Well Record

STATE WELL NO. 1/3W - 5A
COUNTY WASHINGTON
APPLICATION NO. GR-2147

010607

OWNER: William E. Buel

MAILING ADDRESS:

Route 2, Box 36


LOCATION OF WELL: Owner's No.

CITY AND STATE:

Cornelius, Oregon

NE 1/4 NE 1/4 Sec. 5 T. 1 N. S. R. 3 E. W., W.M.

Bearing and distance from section or subdivision corner 1450' S. 39° W.

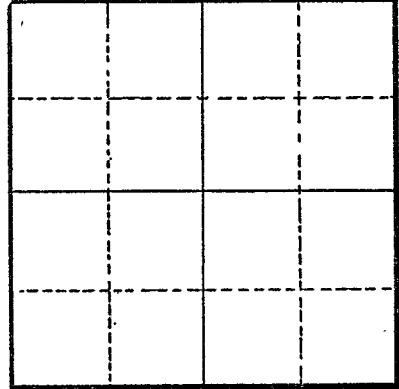

Section

Altitude at well

TYPE OF WELL: Drilled Date Constructed 1953

Depth drilled 38 Depth cased 30

CASING RECORD:

8-Inch

FINISH:

AQUIFERS:

WATER LEVEL:

20-Feet

PUMPING EQUIPMENT: Type Jet Pump

H.P. 1

Capacity 25 G.P.M.

WELL TESTS:

Drawdown ft. after hours Pumping 25 G.P.M.

Drawdown ft. after hours G.P.M.

USE OF WATER Irrigation Temp. °F. 19

SOURCE OF INFORMATION GR-2059

DRILLER or DIGGER

ADDITIONAL DATA:

Log Water Level Measurements Chemical Analysis Aquifer Test

REMARKS: