

STATE ENGINEER
Salem, Oregon

WASH

Well Record

STATE WELL NO. 1/3W-5B
COUNTY Washington
APPLICATION NO. GR-1748

010608

GR 1695

OWNER: Lynn Brooks, Carlton Nursery Co.


MAILING ADDRESS: P.O. Box 8

LOCATION OF WELL: Owner's No.

CITY AND STATE: Forest Grove, Oregon

NW 1/4 NE 1/4 Sec. 5 T. 1 S. R. 3 W., W.M.

Bearing and distance from section or subdivision corner S. 81° W. 1910' from NE cor. Sec. 5

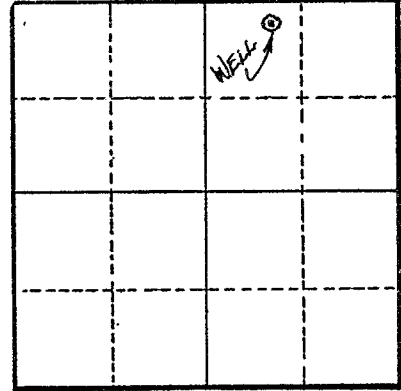

Section 5

Altitude at well

TYPE OF WELL: Drilled Date Constructed 1942

Depth drilled 97' Depth cased 90'

CASING RECORD:

6"

FINISH:

AQUIFERS:

WATER LEVEL:

20'

PUMPING EQUIPMENT: Type Myers Ejecto H.P. 2
Capacity 30 G.P.M.

WELL TESTS:

Drawdown 30 ft. after 35 hours G.P.M.
Drawdown ft. after hours G.P.M.

USE OF WATER Irrigation Temp. °F. 19

SOURCE OF INFORMATION GR Record
DRILLER or DIGGER Baseline Drilling Co.

ADDITIONAL DATA:

Log N.A. Water Level Measurements Chemical Analysis Aquifer Test

REMARKS:

Irrigation of 3 acres.