

STATE ENGINEER
Salem, Oregon

WA
010663


Well Record

STATE WELL NO. 1/3W - 11K
COUNTY WASHINGTON
APPLICATION NO. GR-1973

OWNER: Harold N. and Juaneta Kumar MAILING ADDRESS: 32215 T. V. Highway, Hillsboro, Ore.
CITY AND STATE: _____

LOCATION OF WELL: Owner's No. _____
NW 1/4 SE 1/4 Sec. 11 T. 1 N. S., R. 3 E. W., W.M.

Bearing and distance from section or subdivision corner N/ 2370 & 2430 and W. 2170' to 2 wells

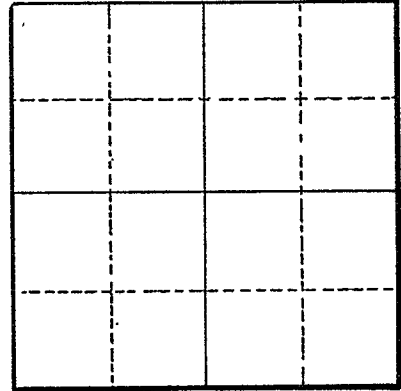

Section _____

Altitude at well _____

TYPE OF WELL: Drilled Date Constructed 1948

Depth drilled 70' Depth cased 76'

CASING RECORD:

6-inch
6-inch

FINISH:

AQUIFERS:

WATER LEVEL:

40-feet

PUMPING EQUIPMENT: Type 2-Peerless H.P. 3/4
Capacity 40 G.P.M.

WELL TESTS:

Drawdown 55 ft. after _____ hours Pumping 110 G.P.M.
Drawdown 55 ft. after _____ hours Pumping 110 G.P.M.

USE OF WATER Manufacturing & Industrial Temp. _____ °F., 19 _____

SOURCE OF INFORMATION GR-1904

DRILLER or DIGGER A. J. Gaunt, Aloha, Oregon

ADDITIONAL DATA:

Log _____ Water Level Measurements _____ Chemical Analysis _____ Aquifer Test _____

REMARKS:

Log not available