

STATE ENGINEER  
Salem, Oregon

WA 54

# Well Record

STATE WELL NO. 1/3W-13G  
COUNTY Washington  
APPLICATION NO. GR-1458

GR-1407

## 010688

OWNER: DR. Paul Bailey

MAILING

ADDRESS: Rt. 2, Box 250

LOCATION OF WELL: Owner's No. #1


CITY AND

STATE: Cornelius, Oregon

SW 1/4 NE 1/4 Sec. 13 T. 1 S., R. 3 W., W.M.

Bearing and distance from section or subdivision

corner S.37°W. 3120' from NE cor. Sec. 13

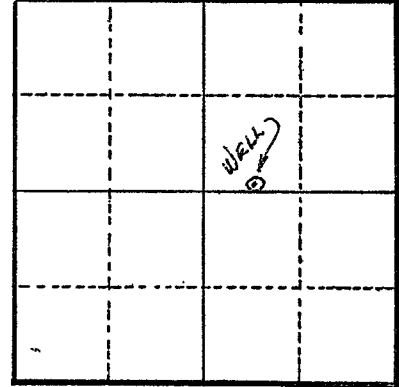

Section 13

Altitude at well

TYPE OF WELL: Drilled Date Constructed 1930

Depth drilled 88' Depth cased 88'

CASING RECORD:

6"

FINISH:

AQUIFERS:

WATER LEVEL:

25'

PUMPING EQUIPMENT: Type Berkeley jet

H.P. 1

Capacity 20 G.P.M.

WELL TESTS:

Drawdown ft. after hours G.P.M.

Drawdown ft. after hours G.P.M.

USE OF WATER Irrigation Temp. °F. 19

SOURCE OF INFORMATION GR Record

DRILLER or DIGGER

ADDITIONAL DATA:

Log N.A. Water Level Measurements Chemical Analysis Aquifer Test

REMARKS:

Irrigation of 1 acre