

STATE ENGINEER
Salem, Oregon

WASH

Well Record

STATE WELL NO. 1/3W-17F(1)
COUNTY Washington
APPLICATION NO. GR-396


010764

OWNER: John Nakai
MAILING ADDRESS: Route 2, Box 458

LOCATION OF WELL: Owner's No. _____
CITY AND STATE: Cornelius, Oregon

SE 1/4 NW 1/4 Sec. 17 T. 1 N. S. R. 3 W., W.M.

Bearing and distance from section or subdivision corner 320' N. & 1540' E. or N. 78° 16' E. 1572.9' from the W 1/4 cor. Sec. 17

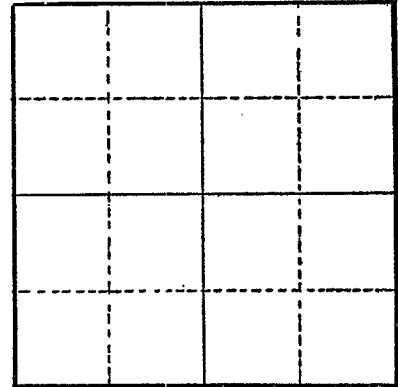

Section _____

Altitude at well 300

TYPE OF WELL: Drilled Date Constructed July '54

Depth drilled 250 Depth cased 250

CASING RECORD:

6 inch to 205 feet
5 inch perforated from 205 feet to 250 feet

FINISH:

AQUIFERS:

WATER LEVEL:

80

PUMPING EQUIPMENT: Type Peerless turbine H.P. 10
Capacity 50 G.P.M.

WELL TESTS:

Drawdown _____ ft. after _____ hours _____ G.P.M.
Drawdown _____ ft. after _____ hours _____ G.P.M.

USE OF WATER Irrigation 30 acres Temp. _____ °F. _____, 19_____

SOURCE OF INFORMATION GR-396

DRILLER or DIGGER Lance Strayer, Beaverton, Oregon

ADDITIONAL DATA:

Log NO Water Level Measurements _____ Chemical Analysis _____ Aquifer Test _____

REMARKS: