

STATE ENGINEER
Salem, Oregon

WASH

Well Record

010845

STATE WELL NO. 1/3w-20.M.O.
COUNTY Washington
APPLICATION NO. GR-4

OWNER: Robert P. and Emma M. Nixon

MAILING ADDRESS:

LOCATION OF WELL: Owner's No.

CITY AND STATE:


Forest Grove, Oregon

NW 1/4 SW 1/4 Sec. 20 T. 1 S., R. 3 W., W.M.

Bearing and distance from section or subdivision

corner 500 feet north of north line of Lot 32

Springhill Farm and 100 ft. East of west line of Section 20

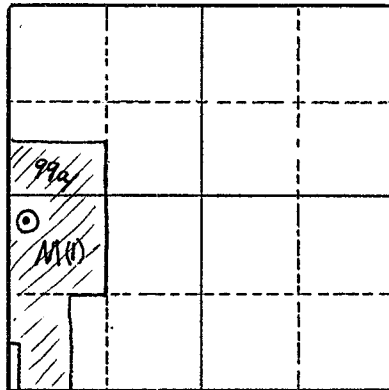

Section 20

Altitude at well 600 feet Interpolated

TYPE OF WELL: Drilled Date Constructed May 1955

Depth drilled 285' Depth cased 249'7"

CASING RECORD:

8 inch casing set from 0 to 249 feet

FINISH:

Perforations at 105 feet

AQUIFERS:

Basalt from 95 feet to 285 feet

WATER LEVEL:

180 feet to static level measured - May, 1955

PUMPING EQUIPMENT: Type Peerless

H.P. 25

Capacity 250 G.P.M.

WELL TESTS:

Drawdown 30 ft. after _____ hours 2.50 G.P.M.

Drawdown _____ ft. after _____ hours _____ G.P.M.

USE OF WATER Domestic - Irrigation Temp. _____ °F, 19 _____

SOURCE OF INFORMATION Registration Statement GR-4

DRILLER or DIGGER _____

ADDITIONAL DATA:

Log Water Level Measurements Chemical Analysis _____ Aquifer Test _____

REMARKS:

