

STATE ENGINEER
Salem, Oregon

WASH OBSERVATION WELL
Well Record

STATE WELL NO. 1/3W-21C(2)
COUNTY Washington
APPLICATION NO. GR-891

010851

OWNER: Ernest Meyer


MAILING ADDRESS: Rt. 2, Box 431

LOCATION OF WELL: Owner's No.

CITY AND STATE: Cornelius

NE 1/4 NW 1/4 Sec. 21 T. 1 S., R. 3 W., W.M.

Bearing and distance from section or subdivision
corner 2100 ft. South 70° 0' East

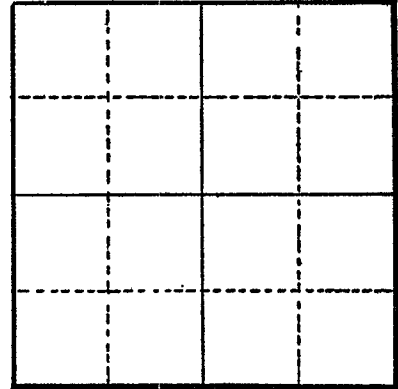

Section 21

Altitude at well 200

TYPE OF WELL: drilled Date Constructed 1956

Depth drilled 600 Depth cased 303

CASING RECORD:

8" steel 0' - 303'

FINISH:

8" steel casing 0' to 303'

8" hole 303' to 400'
6" hole 400' to 600'

AQUIFERS:

WATER LEVEL:

3 feet

PUMPING EQUIPMENT: Type Sumo Submersible 4" H.P. 17 Elec.
Capacity 150 G.P.M.

WELL TESTS:

Drawdown 240 ft. after 65 ? hours G.P.M.
Drawdown 240 ft. after 130 ? hours G.P.M.

USE OF WATER Irrigation Temp. °F., 19

SOURCE OF INFORMATION Ground Water Registration Statement

DRILLER or DIGGER Barron & Strayer - Beaverton, Oregon

ADDITIONAL DATA:

Log NA Water Level Measurements Chemical Analysis Aquifer Test

REMARKS:

Well flowing 3 g.p.m. - 2/25/56