

STATE ENGINEER  
Salem, Oregon

WASH

Well Record

STATE WELL NO. 1/3W-21H(1)  
COUNTY Washington  
APPLICATION NO. GR-359

010852

OWNER: Henry Neuman

MAILING ADDRESS:

Rt. 2, Box 422


LOCATION OF WELL: Owner's No.

CITY AND STATE:

Cornelius, Oregon

SE 1/4 NE 1/4 Sec. 21 T. 1 S, R. 3 W., W.M.

Bearing and distance from section or subdivision corner 540 ft. North & 235 ft. West from the E/4 corner of Section 21

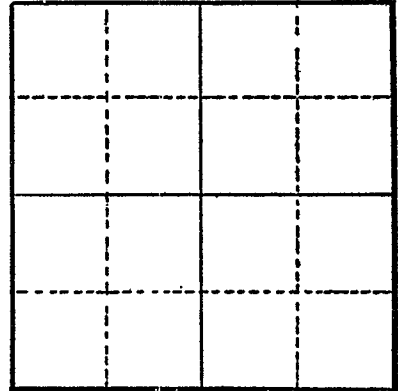

Section 21

Altitude at well 220 ft.

TYPE OF WELL: drilled Date Constructed June 1952

Depth drilled 370 Depth cased 370

CASING RECORD:

8 inch

FINISH:

AQUIFERS:

WATER LEVEL:

20 - 25

PUMPING EQUIPMENT: Type Submersible Jacuzzi H.P. 10  
Capacity 225 G.P.M.

WELL TESTS:

Drawdown ft. after hours G.P.M.  
Drawdown ft. after hours G.P.M.

USE OF WATER irrigation Temp. °F., 19

SOURCE OF INFORMATION Ground Water Registration Record

DRILLER or DIGGER Harty Bros. Drilling Company

ADDITIONAL DATA:

Log no Water Level Measurements Chemical Analysis Aquifer Test

REMARKS: