

STATE ENGINEER
Salem, Oregon

WASH

Well Record

STATE WELL NO. 1S/3W-22E(1)
COUNTY Washington
APPLICATION NO.

010862

OWNER: R. Meyer


MAILING ADDRESS:

LOCATION OF WELL: Owner's No.

CITY AND STATE:

1/4 1/4 Sec. T. N. S., R. E. W., W.M.

Bearing and distance from section or subdivision corner

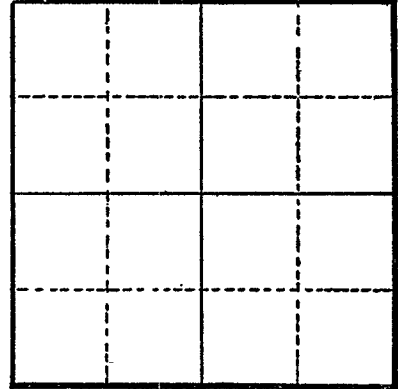

Section

Altitude at well 240 feet

TYPE OF WELL: drilled Date Constructed

Depth drilled 161 feet Depth cased 116 feet

CASING RECORD:

6 inch

FINISH:

AQUIFERS:

Basalt from 100 to 161 ft.

WATER LEVEL:

PUMPING EQUIPMENT: Type Turbine H.P.
Capacity G.P.M.

WELL TESTS:

Drawdown ft. after hours G.P.M.
Drawdown ft. after hours G.P.M.

USE OF WATER domestic & irrigation Temp. °F., 19

SOURCE OF INFORMATION U.S.G.S.

DRILLER or DIGGER

ADDITIONAL DATA:

Log Water Level Measurements Chemical Analysis Aquifer Test

REMARKS:

Used for irrigating 16 acres of pasture; flows about 1/2 g.p.m.