

STATE ENGINEER
Salem, Oregon

WASH

Well Record

Pg 1 of 2

011043

STATE WELL NO. 113W-33K (1)
COUNTY Wash.
APPLICATION NO. GR-490

OWNER: Alex Fishen


MAILING ADDRESS: Pt. 1 Box 2B.

LOCATION OF WELL: Owner's No.

CITY AND STATE: Cornelius, Ore

NW 1/4 SE 1/4 Sec. 33 T. 1 N., R. 3 W., W.M.

Bearing and distance from section or subdivision corner 2090 Ft. N. & 1955 Ft. N.
from S.E. cor. sec. 33

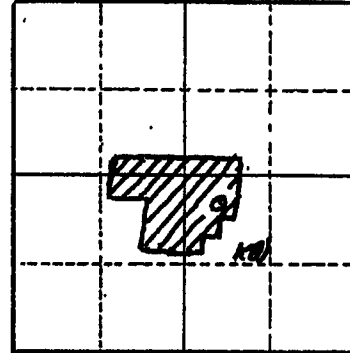

Section 33

Altitude at well 75

TYPE OF WELL: drilled Date Constructed Aug. 53

Depth drilled 50 Depth cased 50

CASING RECORD:

6 inch

FINISH:

AQUIFERS:

WATER LEVEL:

14

PUMPING EQUIPMENT: Type Berkeley H.P. 2 1/2
Capacity 40 G.P.M.

WELL TESTS:

Drawdown ft. after hours G.P.M.

Drawdown ft. after hours G.P.M.

USE OF WATER irrigation - 53 Ac. Temp. °F., 19....

SOURCE OF INFORMATION GR-490

DRILLER or DIGGER

ADDITIONAL DATA:

Log Water Level Measurements Chemical Analysis Aquifer Test

REMARKS:

