

STATE ENGINEER
Salem, Oregon

WASH

Well Record


011139

STATE WELL NO. 1/4W-3B
COUNTY Washington
APPLICATION NO. GR-1954

OWNER: Frederick William Lunger
MAILING ADDRESS: Route 1, Box 219
CITY AND STATE: Forest Grove, Oregon

LOCATION OF WELL: Owner's No.
NW 1/4 NE 1/4 Sec. 3 T. 1 S. R. 4 W., W.M.

Bearing and distance from section or subdivision
corner 1120 feet East and 400 feet South from N1/4
Corner,

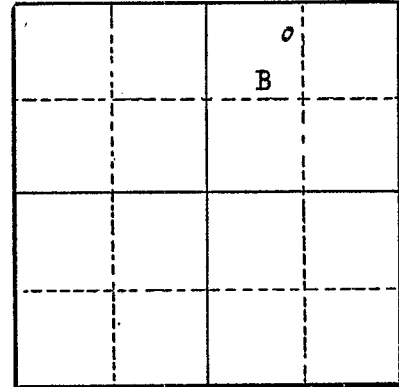

Section 3

Altitude at well 150 feet

TYPE OF WELL: Drilled Date Constructed 5-1949

Depth drilled 112 feet Depth cased 111 feet

CASING RECORD:

6-inch steel casing set from 0 to 111 feet

FINISH:

AQUIFERS:

sand and clay, gravels

WATER LEVEL:

40 feet

PUMPING EQUIPMENT: Type Jet H.P. 3/4
Capacity 6 G.P.M.

WELL TESTS:

Drawdown 40 ft. after 12 hours G.P.M.
Drawdown ft. after hours G.P.M.

USE OF WATER Garden Temp. °F., 19

SOURCE OF INFORMATION GR-4102

DRILLER or DIGGER Frank Blair Forest Grove, Oregon

ADDITIONAL DATA:

Log x Water Level Measurements Chemical Analysis Aquifer Test

REMARKS:

gravels at 109 feet - sand and clay entire depth to aquifer